

Interim Seismic Retrofit-East Bay Cantilever Truss (Contract No. 04-043004)

The as-built drawings, which are contained in these CDs, are scanned from drawings of the existing structure for the convenience of the contractor and as a means to convey to the contractor the available information regarding the existing structure. It is to be understood that no claim is being made as to the accuracy or completeness of the said information and that the State of California or its officers or agents shall not be responsible for the manner in which the contractor interprets and uses this information or for the accuracy, currency or completeness of these scanned as-built drawings. The contractor shall be responsible to obtain, at the contractor's expense, any additional information that the contractor deems necessary for completely and accurately assessing the existing conditions of the structure. The contractor shall not be entitled to any compensation for any claim arising from inaccuracy or insufficiency of these as-built drawings or in anyway related to these drawings.

[105.General Plan No. 1](#)

[106.General Plan No. 2](#)

[107.Index to Plans](#)

[108.Floor Beam Details No. 1](#)

[109.Floor Beam Details No. 2](#)

[110.Floor Beam Details No. 3](#)

[111.Floor Beam Details No. 4](#)

[112.Floor Beam Details No. 5](#)

[113.Piers E2, E3 Details No. 1](#)

[114.Piers E2, E3 Details No2](#)

[115.Pier E4 Details No. 1](#)

[116.Pier E4 Details No. 2](#)

[117.Pier E4 Details No. 3](#)

[118.Pier E4 Details No. 4](#)

[119.Pier E4 Details No. 5](#)

[120.Pier E4 Bumper Details No. 1](#)

[121.Pier E4 Bumper Details No. 2](#)


[122.Pier E4 Bumper Details No. 3](#)

DIST.	COUNTY	ROUTE	POST MILES TOTAL PROJECT	SHEET NO.	TOTAL SHEETS
04	SF, Alameda	80	7.8/8.9 0.0/1.1	105	205



James S. MacIntyre
REGISTERED ENGINEER - CIVIL
October 22, 1997

12-8-97
PLANS APPROVAL DATE

The State of California or its officers or agents shall not be responsible for the accuracy or completeness of electronic copies of this plan sheet.

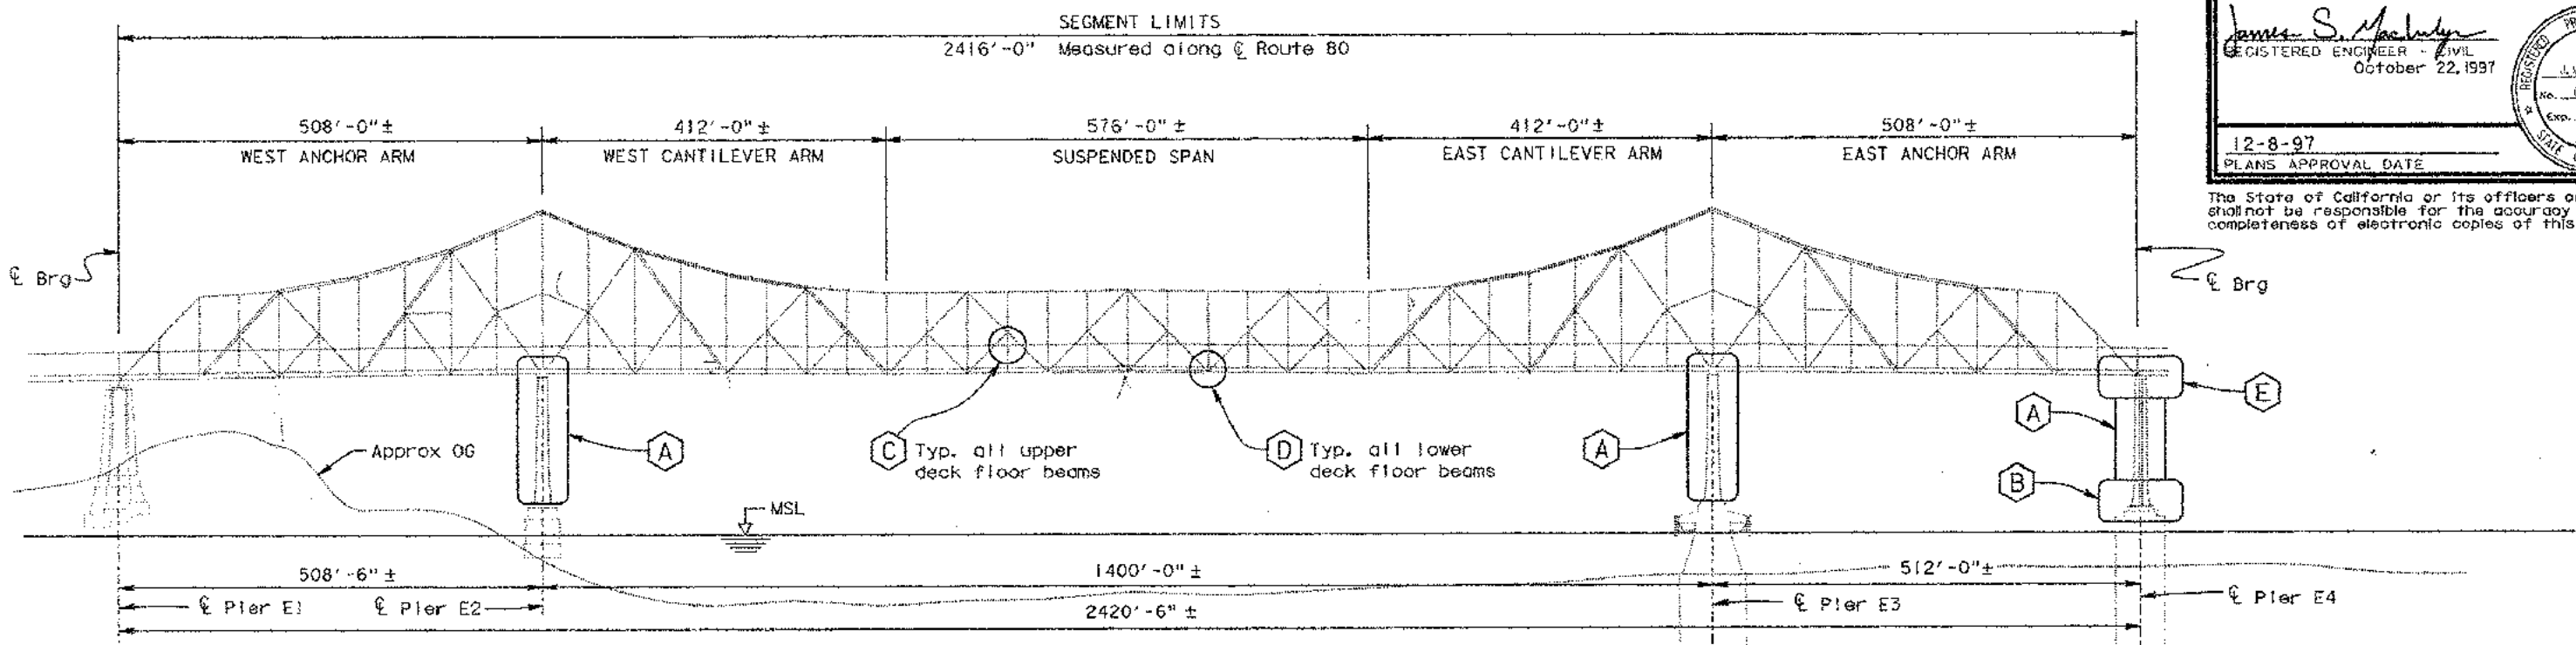

ELEVATION
1" = 100'

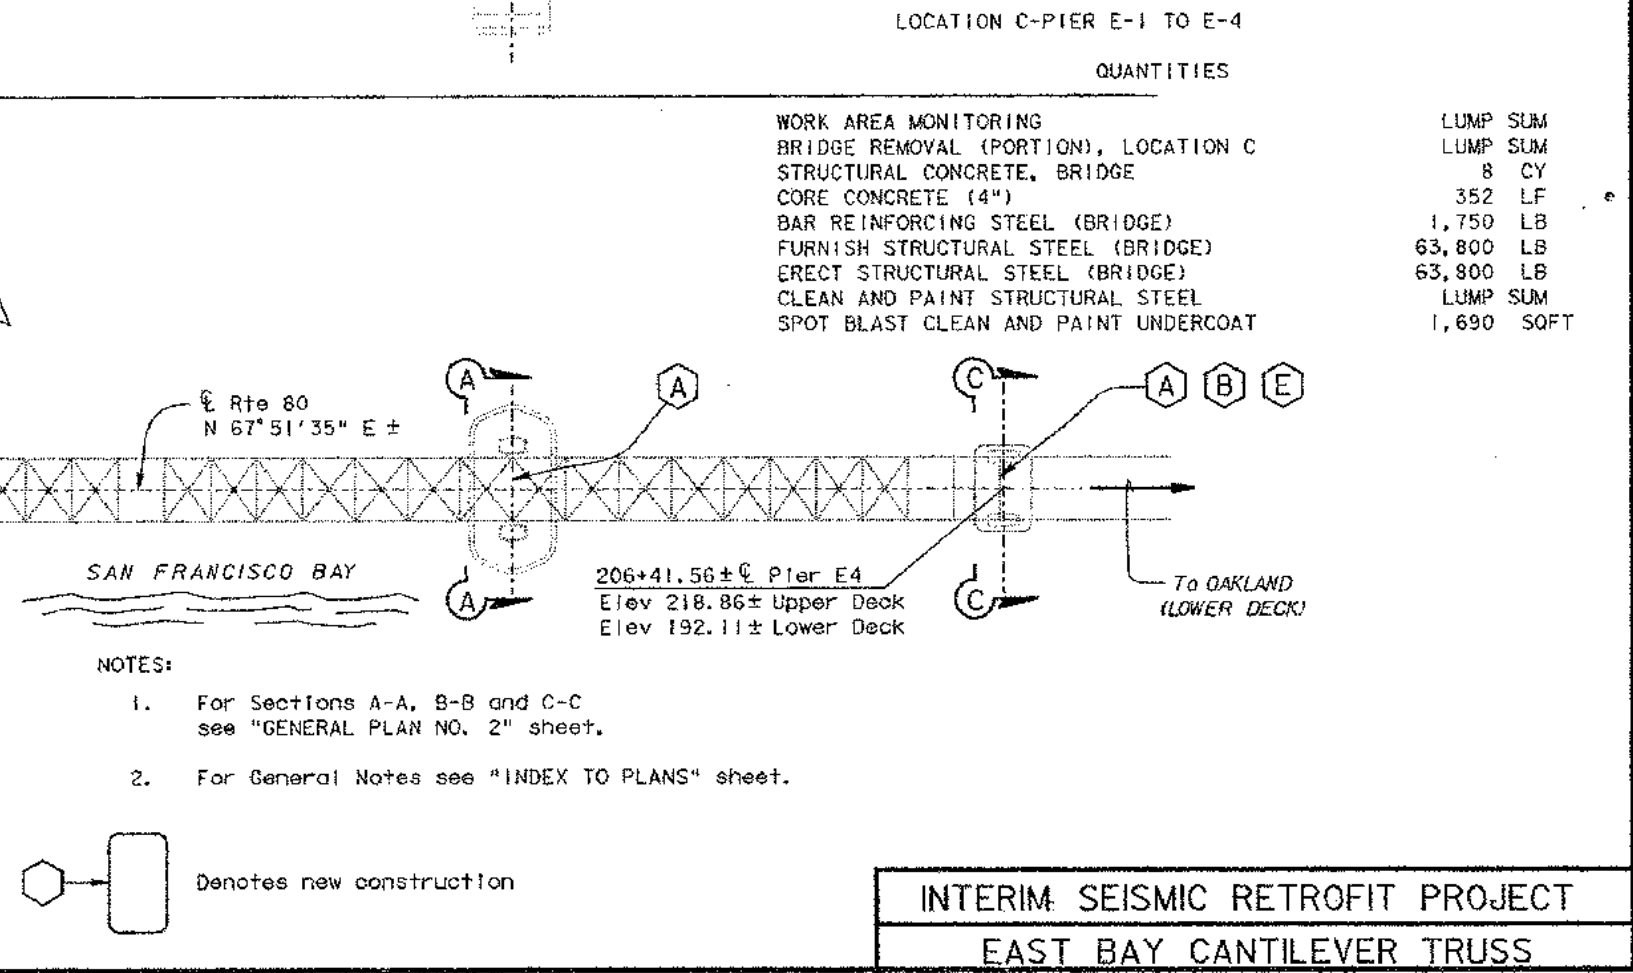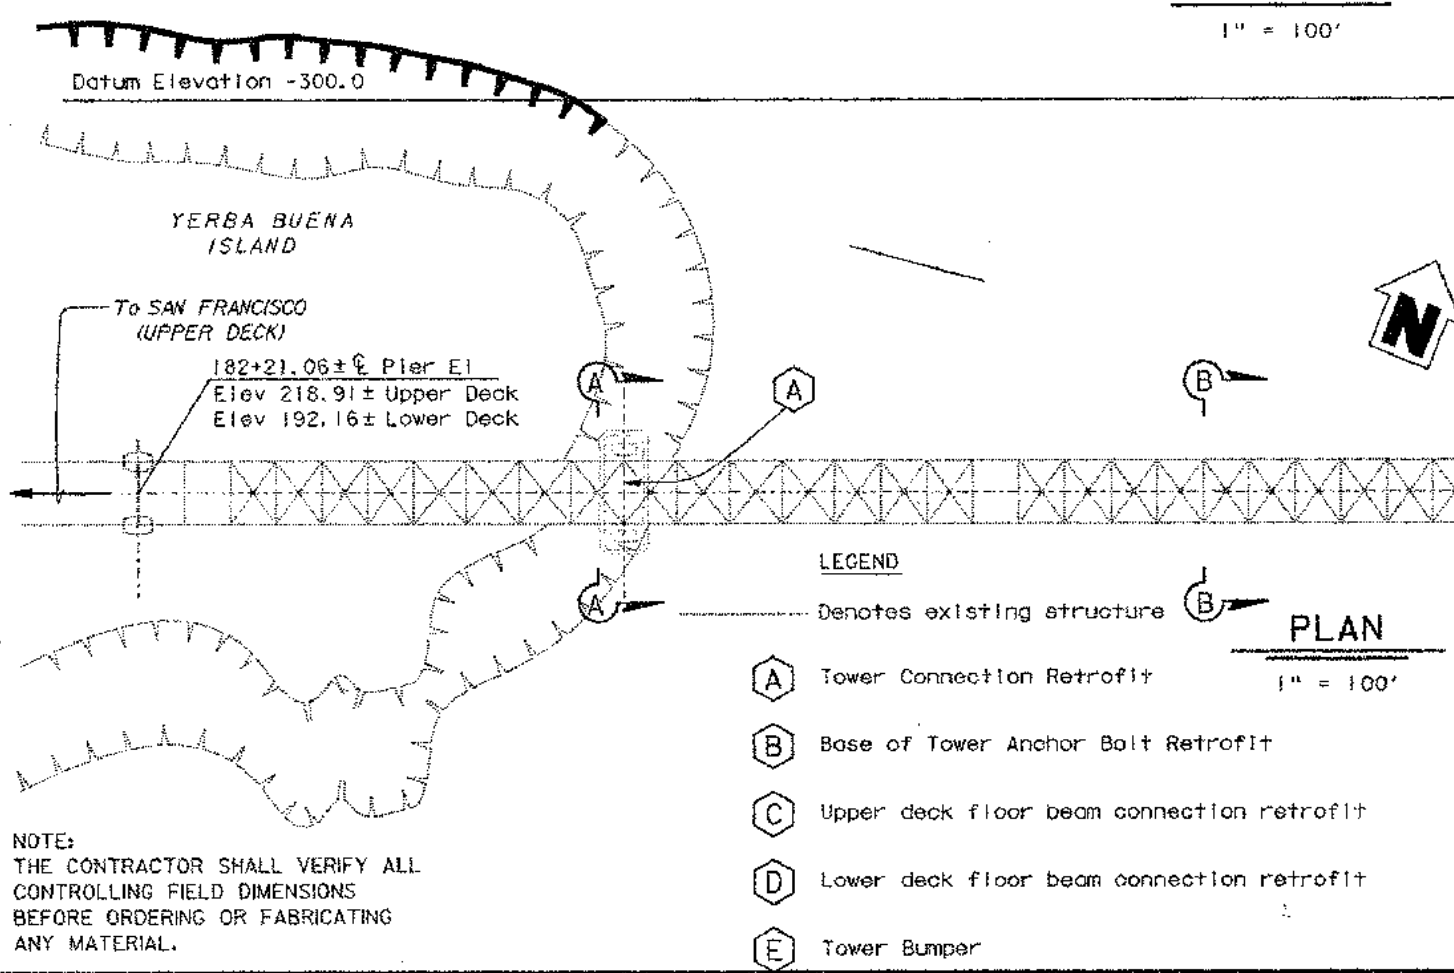

DESIGN		BY J. MACINTYRE 4-97	CHECKED J. GUNDBROM 5-97	STATE OF CALIFORNIA		DIVISION OF STRUCTURES		BRIDGE NO. 33-0025		INTERIM SEISMIC RETROFIT PROJECT											
DETAILS		BY D.A. SANDERSON 4-97	CHECKED J. GUNDBROM 5-97	DEPARTMENT OF TRANSPORTATION		STRUCTURE DESIGN		POST MILE 1.15		EAST BAY CANTILEVER TRUSS											
QUANTITIES		BY	CHECKED	TOLL BRIDGE SPECIAL ANALYSIS		CU 04 EA 043001		DISREGARD PRINTS BEARING EARLIER REVISION DATES		SAN FRANCISCO-OAKLAND BAY BRIDGE											
								REVISION DATES (PRELIMINARY STAGE ONLY)		GENERAL PLAN NO. 1											
								<table border="1"> <tr> <td>4-28-97</td> <td>5-28-97</td> <td>5-28-97</td> <td>5-28-97</td> <td>5-28-97</td> <td>5-28-97</td> <td>5-28-97</td> <td>5-28-97</td> <td>5-28-97</td> <td>5-28-97</td> </tr> </table>		4-28-97	5-28-97	5-28-97	5-28-97	5-28-97	5-28-97	5-28-97	5-28-97	5-28-97	5-28-97	SHEET 1 OF 18	
4-28-97	5-28-97	5-28-97	5-28-97	5-28-97	5-28-97	5-28-97	5-28-97	5-28-97	5-28-97												


DATE PLOTTED: 9-Dec-1997
TIME PLOTTED: 08:31

DIST.	COUNTY	ROUTE	POST MILES TOTAL PROJECT	SHEET NO.	TOTAL SHEETS
04	SF, Alameda	80	7.8/8.9, 0.0/1.1	106	205

James S. MacIntyre
 REGISTERED ENGINEER - CIVIL
 October 22, 1997


12-8-97
 PLANS APPROVAL DATE

The State of California or its officers or agents shall not be responsible for the accuracy or completeness of electronic copies of this plan sheet.

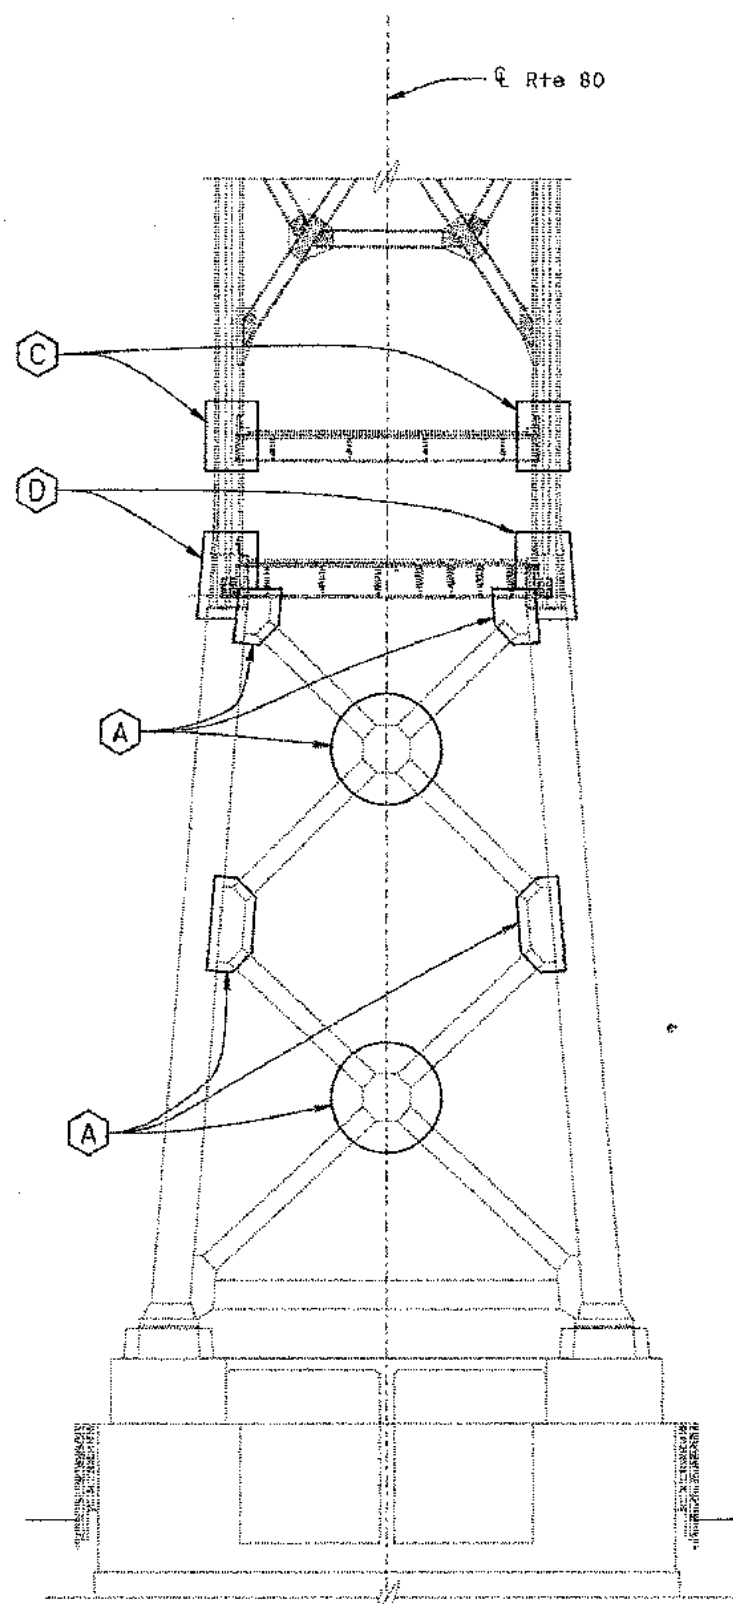


SECTION A-A

1" = 20'

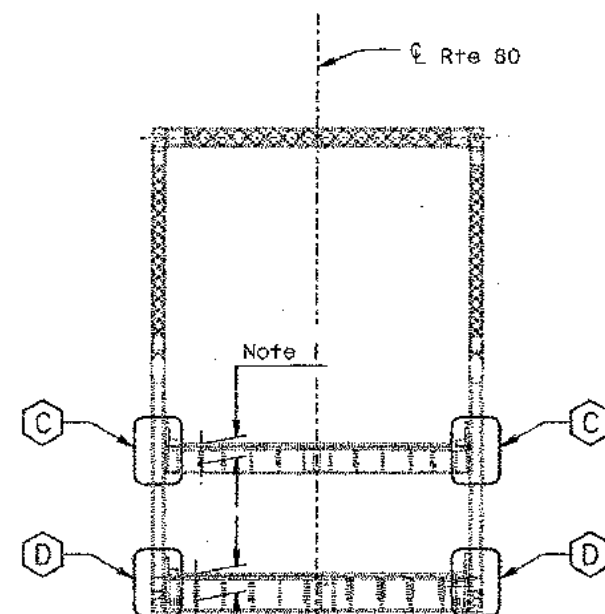

SECTION B-B

1" = 20'

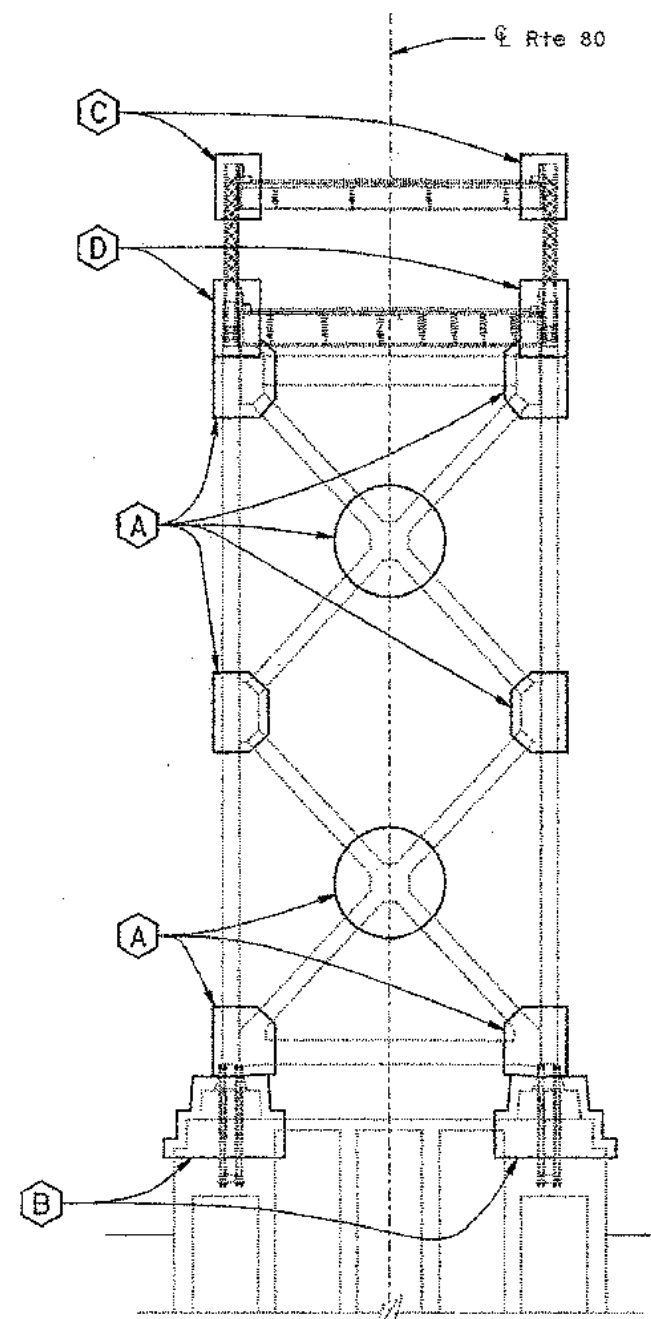

SECTION C-C

1" = 20'

LEGEND

Denotes existing structure

- A Tower Connection Retrofit
- B Base of Tower Anchor Bolt Retrofit
- C Upper Deck Floor Beam Connection Retrofit
- D Lower Deck Floor Beam Connection Retrofit
- E Tower Bumper

Notes:

1. 4'-2 1/2" ± - Top of upper deck to bottom of north exterior stringer.
2. 5'-6" ± - Top of lower deck to bottom of north exterior stringer.
3. For limits of floor beam retrofit type C and D see "General Plan No. 1" sheet.
4. For location of Section A-A, B-B and C-C see "General Plan No. 1" sheet.

NOTE:
THE CONTRACTOR SHALL VERIFY ALL CONTROLLING FIELD DIMENSIONS BEFORE ORDERING OR FABRICATING ANY MATERIAL.

INTERIM SEISMIC RETROFIT PROJECT

EAST BAY CANTILEVER TRUSS

SAN FRANCISCO-OAKLAND BAY BRIDGE

GENERAL PLAN NO. 2

DESIGN	BY	DATE	CHECKED	DATE	LAYOUT	BY	DATE	CHECKED	DATE	STATE OF CALIFORNIA	DIVISION OF STRUCTURES	BRIDGE NO.	POST MILE	DATE	REVISION	SHEET	TOTAL
DESIGN	J. MACINTYRE	4-97	J. SUNDBLUM	5-97	LAYOUT	J. MACINTYRE	4-97	J. SUNDBLUM	5-97	STATE OF CALIFORNIA	DIVISION OF STRUCTURES	33-0025	1.5	5/28/97	5/28/97	2	18
DETAILS	D.A. SANDERSON	4-97	J. SUNDBLUM	5-97						DEPARTMENT OF TRANSPORTATION	STRUCTURE DESIGN			5/28/97	5/28/97		
QUANTITIES	P. WAYZ	5-97	J. SUNDBLUM/J. MACINTYRE	5-97	SPECIFICATIONS						TOLL BRIDGE SPECIAL ANALYSIS			5/28/97	5/28/97		

ORIGINAL SCALE IN INCHES FOR REDUCED PLANS
 DISCARD PRINTS BEARING EARLIER REVISION DATES
 CU 04 EA 043001

DATE PLOTTED 9-8-97
TIME PLOTTED 08:32

GENERAL NOTES
LOAD AND RESISTANCE FACTOR DESIGN

DESIGN: 1994 AASHTO LRFD BRIDGE DESIGN SPECIFICATIONS AND
SAN FRANCISCO-OAKLAND BAY BRIDGE WEST SPAN SEISMIC
RETROFIT DESIGN CRITERIA

REINFORCED CONCRETE: (NEW)

GRADE 60 ASTM A706
 $f_y = 60,000 \text{ psi}$
 $f'_c = 4,000 \text{ psi}$

REINFORCED CONCRETE: (EXISTING) $f_y = 33,000$ psi
 $f'_c = 5,000$ psi

STRUCTURAL STEEL (NEW) ASTM A36 UNLESS OTHERWISE NOTED
 $f_y = 36,000$ psi

STRUCTURAL STEEL (EXISTING)	MEDIUM CARBON STEEL $f_y = 37,000 \text{ psi}$ $f_u = 62,000 \text{ psi}$
-----------------------------------	---

SILICON STEEL
 $f_y = 45,000 \text{ psi}$
 $f_u = 80,000 \text{ psi}$

NICKEL STEEL
 $f_y = 55,000 \text{ psi}$
 $f_u = 90,000 \text{ psi}$

ANCHOR BOLTS ASTM F1554 GRADE 36 UNLESS OTHERWISE NOTED

HIGH STRENGTH
BOLTS ASTM A325 UNLESS OTHERWISE NOTED

HIGH STRENGTH
THREADED RODS ASTM A354 GRADE BD UNLESS OTHERWISE NOTED

WELDS E70XX UNLESS OTHERWISE NOTED

GENERAL NOTES


1. All new connection bolts shall be high strength bolts and shall conform to ASTM A325 bearing type unless otherwise noted in the plans. All high strength bolts in standard size holes shall be furnished with one washer beneath the turning element. All high strength bolts in oversized holes shall be furnished with two hardened washers (conforming to ASTM F436), with one washer beneath the bolt and with one washer beneath the nut. Heads of all bolts shall be on the outside face of the member as practical, unless otherwise noted. Bolt threads shall be excluded from the shear planes.
2. Maintenance platforms and ladders interfering with the new construction and not shown in Road Plans shall be temporarily removed or modified as required and reinstalled as approved by the Engineer.
3. Drain pipes to be removed as required for retrofit and reinstalled as approved by the Engineer.
4. For utilities and highway facilities, such as air, water and electrical utility relocation, see Road Plans.
5. For traffic controls, see Road Plans.
6. "Near Side" of a member or connection in the plans refers to the side shown.
"Far Side" of a member or connection in the plans refers to the other side of the same member or connection from the side shown.
7. All retrofit construction shown in the plans is symmetrical about centerline of roadway, unless otherwise noted.
8. Anchor bolts to be ASTM F1554 Grade 36.

INDEX TO PLANS

<u>SHEET NO.</u>	<u>TITLE</u>
1.	GENERAL PLAN NO. 1
2.	GENERAL PLAN NO. 2
3.	INDEX TO PLANS
4.	FLOOR BEAM DETAILS NO. 1
5.	FLOOR BEAM DETAILS NO. 2
6.	FLOOR BEAM DETAILS NO. 3
7.	FLOOR BEAM DETAILS NO. 4
8.	FLOOR BEAM DETAILS NO. 5
9.	PIERS E2, E3 DETAILS NO. 1
10.	PIERS E2, E3 DETAILS NO. 2
11.	PIER E4 DETAILS NO. 1
12.	PIER E4 DETAILS NO. 2
13.	PIER E4 DETAILS NO. 3
14.	PIER E4 DETAILS NO. 4
15.	PIER E4 DETAILS NO. 5
16.	PIER E4 BUMPER DETAILS NO. 1
17.	PIER E4 BUMPER DETAILS NO. 2
18.	PIER E4 BUMPER DETAILS NO. 3

STANDARD PLANS DATED JULY 1992

AIOA ABBREVIATIONS

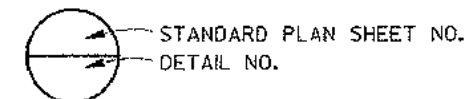

NOTE:
THE CONTRACTOR SHALL VERIFY ALL
CONTROLLING FIELD DIMENSIONS
BEFORE ORDERING OR FABRICATING
ANY MATERIAL.

	DESIGN	BY J. MAGINTYRE 4-97	CHECKED J. SUNDSTROM 5-97	STATE OF CALIFORNIA DEPARTMENT OF TRANSPORTATION	DIVISION OF STRUCTURES STRUCTURE DESIGN TOLL BRIDGE SPECIAL ANALYSIS	BRIDGE NO.	SAN FRANCISCO-OAKLAND BAY BRIDGE		
	DETAILS	BY D.A. SANDERSON 4-97	CHECKED J. SUNDSTROM 5-97			33-0025			
	QUANTITIES	BY P. WATZ 5-97	CHECKED J. SZIMERS/O. MAGINTYRE 5-97			POST MILE 1.15		INDEX TO PLANS	
DS OSD 2139 (CADD 9/95)	ORIGINAL SCALE IN INCHES FOR REDUCED PLANS				CU 04 EA 043001	DISREGARD PRINTS BEARING EARLIER REVISION DATES →	REVISION DATA (PRELIMINARY STAGE ONLY) 5-8-97 5-9-97 6-4-97 6-28-97 6-28-97 8-2-97 8-29-97	SHEET 3	OF 18

```

US[CRNAME => trmike5!
caltp_09080534

```


DATE PLOTTED > 9-DEC-1997
TIME PLOTTED => 08:33

DIST.	COUNTY	ROUTE	POST MILES TOTAL PROJECT	SHEET NO.	TOTAL SHEETS
04	SF, Ala	80	7.8/8.9, 0.0/1.1	108	205

James S. MacIntyre
 REGISTERED ENGINEER - CIVIL
 October 22, 1997
 No. C 47564
 Exp. 12-31-99
 CIVIL
 STATE OF CALIFORNIA

12-8-97
 PLANS APPROVAL DATE

The State of California or its officers or agents shall not be responsible for the accuracy or completeness of electronic copies of this plan sheet.

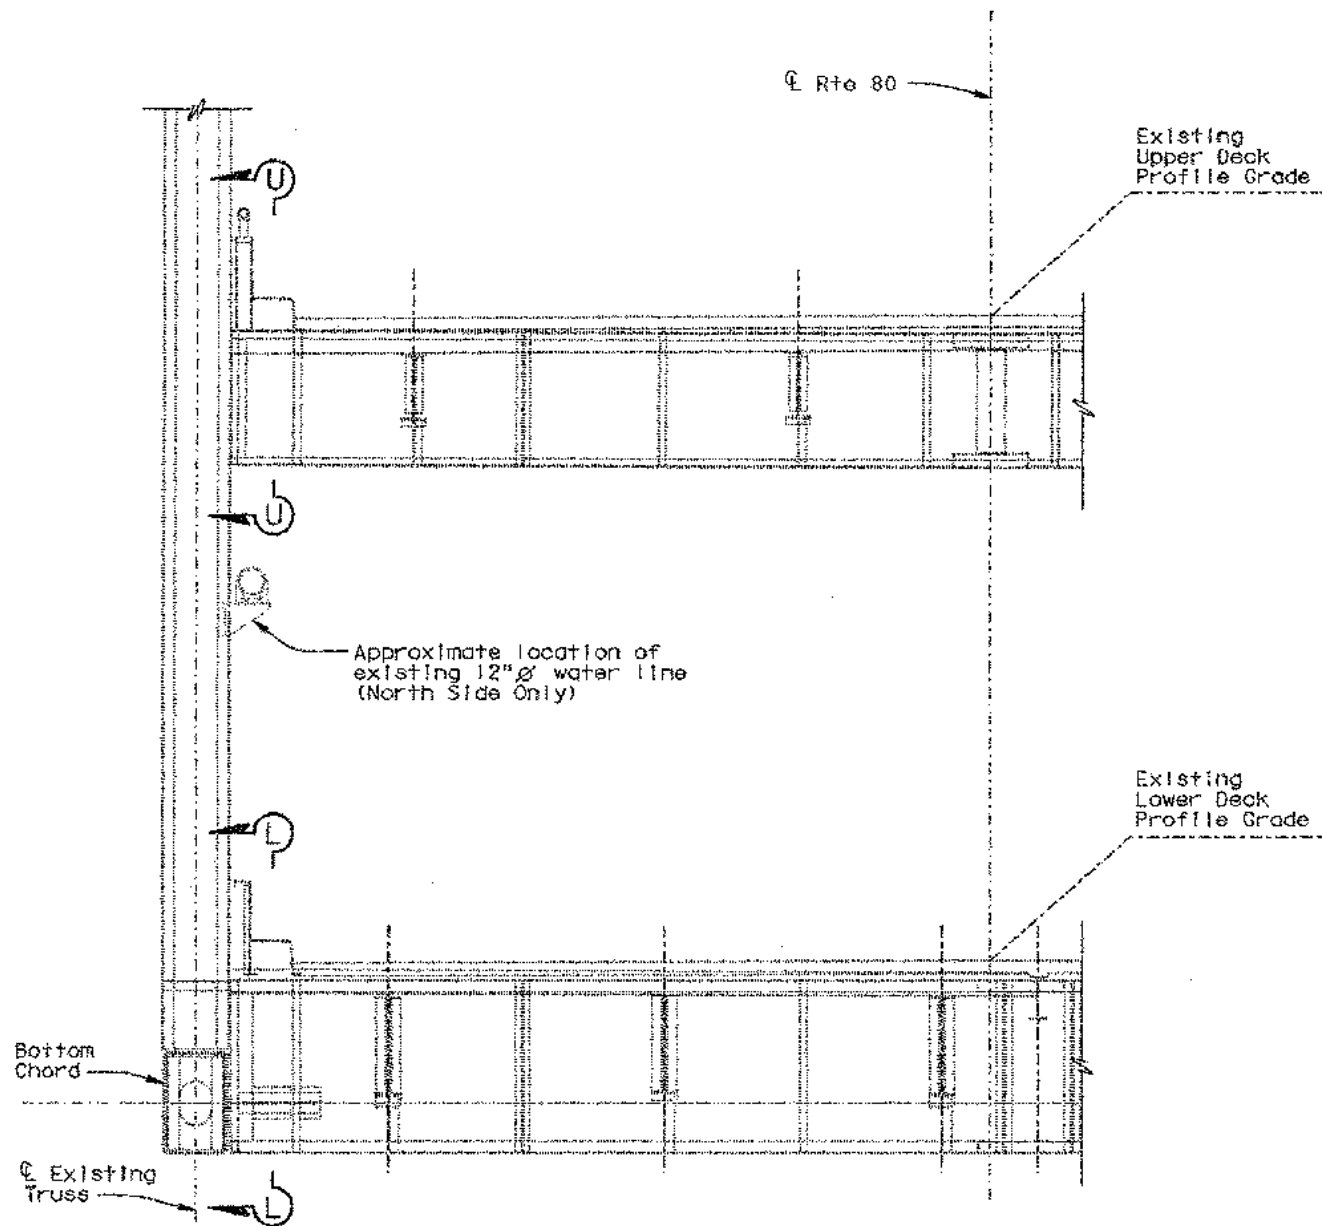

TYPICAL PART ELEVATION

1/4" = 1'-0"

NOTE:

For Sections U-U see
"Floor Beam Details No. 2" sheet.


For Sections L-L see
"Floor Beam Details No. 3,
4 and 5 sheets.

NOTE:

THE CONTRACTOR SHALL VERIFY ALL
CONTROLLING FIELD DIMENSIONS
BEFORE ORDERING OR FABRICATING
ANY MATERIAL.

LEGEND

indicates existing structures.

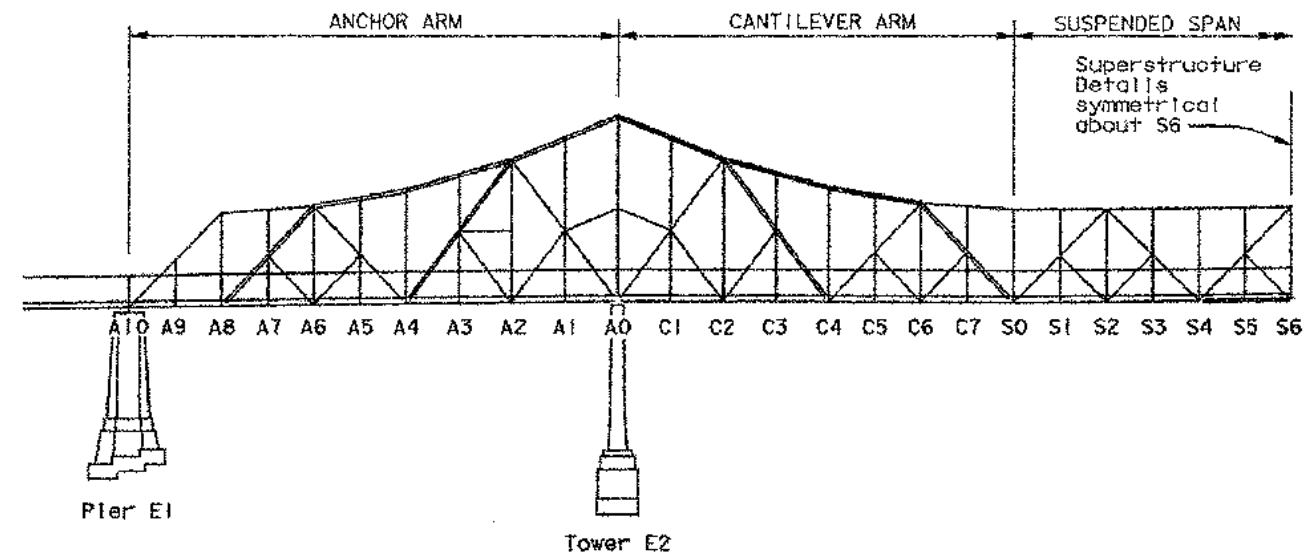

FLOOR BEAM LOCATION DIAGRAM

1" = 100'

FLOOR BEAM ENDS


INSTALLATION NOTES:

1. Rivet replacement with HS bolts shall begin with the center-most pair of rivets and continue, by pairs, alternating above and below the starting pair.
2. All bolts shall be fully tensioned prior to removing any additional rivets.
3. Only one end of a floor beam shall be worked on at any one time.
4. Only non-adjacent floor beam ends shall be worked on simultaneously.
5. New bolts shall be the same size, or larger as required, as the rivets being replaced.
6. Rivets which cannot be removed without damaging the adjacent steel shall be cored out, leaving a hole 3/16" larger in diameter than the diameter of the removed rivet. The new HS bolt shall have a diameter which is 1/16" smaller than the cored hole.


DESIGN BY J. GUNSTROM 3-97 CHECKED J. MACINTYRE 5-97		STATE OF CALIFORNIA		DIVISION OF STRUCTURES		BRIDGE NO. 33-0025		INTERIM SEISMIC RETROFIT PROJECT	
DETAILS BY D.A. SANDERSON 3-97 CHECKED J. MACINTYRE 5-97		DEPARTMENT OF TRANSPORTATION		STRUCTURE DESIGN		POST MILE 1.15		EAST BAY CANTILEVER TRUSS	
QUANTITIES BY P. WATZ 5-97 CHECKED J. STANBRO/J. MACINTYRE 5-97				TOLL BRIDGE SPECIAL ANALYSIS				SAN FRANCISCO-OAKLAND BAY BRIDGE	
								FLOOR BEAM DETAILS NO. 1	
16-050 2155 SCALE 1/8"=1'-0"		ORIGINAL SCALE IN INCHES FOR REDUCED PLANS		CU 04 EA 043001		DISREGARD PRINTS BEARING EARLIER REVISION DATES		SHEET 4 OF 18	

DATE PLOTTED: 9-19-97 TIME PLOTTED: 08:54


The State of California or its officers or agents shall not be responsible for the accuracy or completeness of electronic copies of this plan sheet.

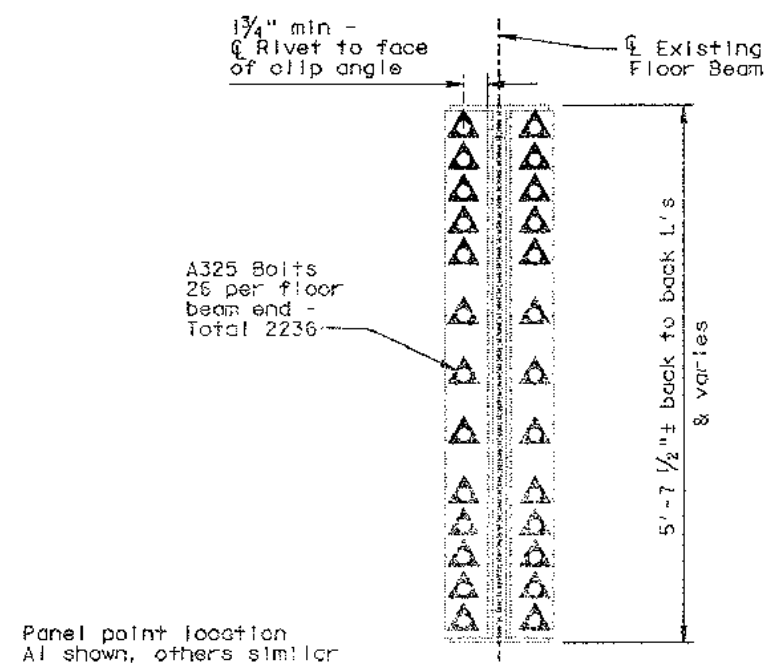

TYPICAL SECTION U-U
1" = 1'-0"

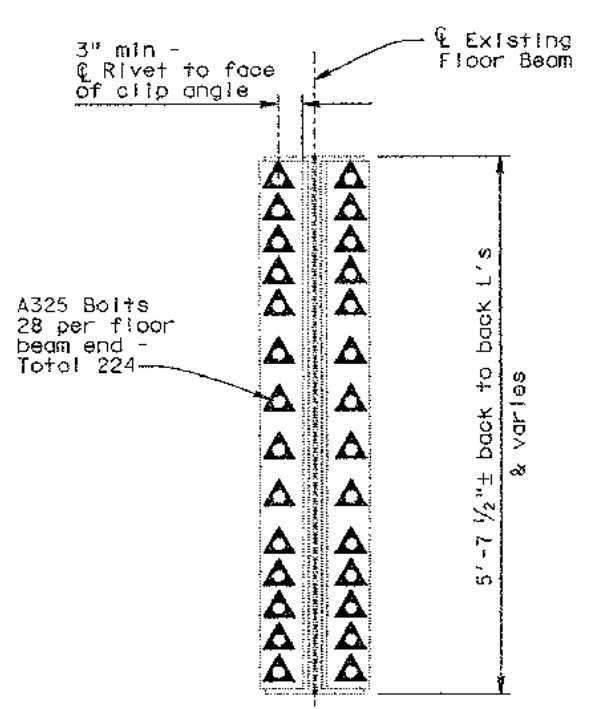

SECTION U-U
1" = 1'-0"
UPPER FLOOR BEAM LOCATIONS
A6, A8

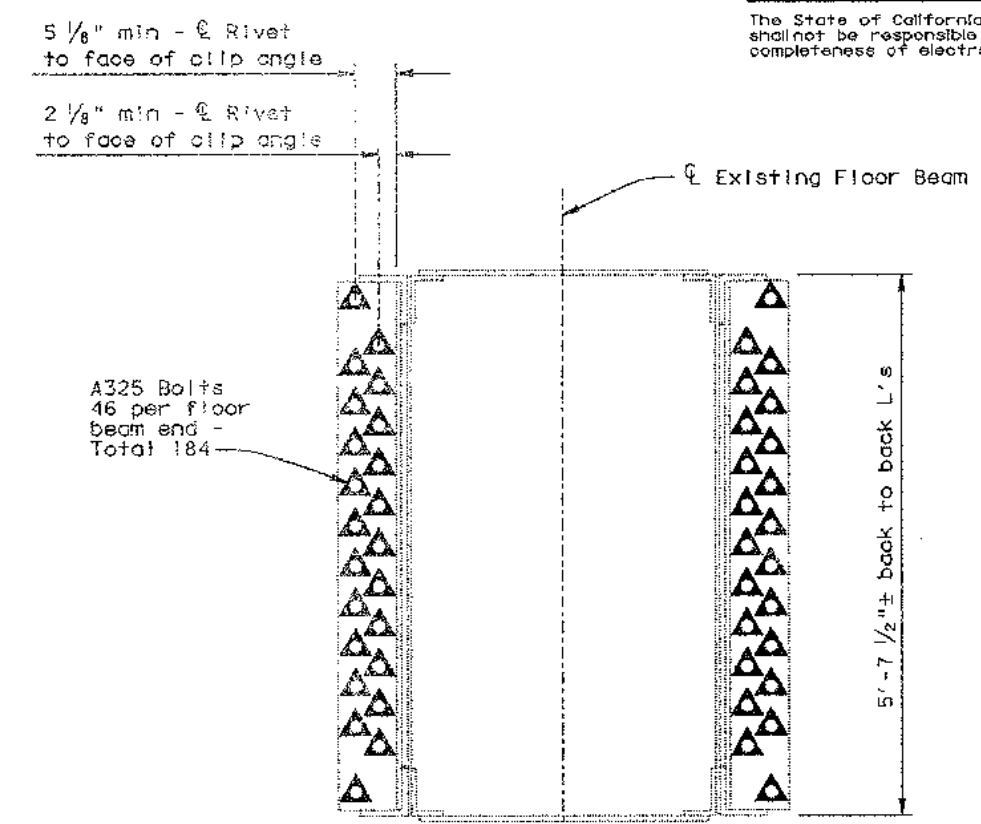

SECTION U-U
1" = 1'-0"
UPPER FLOOR BEAM LOCATIONS
A0

LOCATION	NUMBER OF RIVETS	APPROXIMATE GRIP LENGTH (Inches)
A10	52	5/8
A9	52	1 1/8
A8	56	7/8
A7	52	1 1/4
A6	56	2 13/16
A5	52	1 1/8
A4	52	7/8
A3	52	3/4
A2	52	7/8
A1	52	1 1/4
A0	92	2 7/8
C1	52	3/16
C2	52	7/8
C3	52	3/16
C4	52	3/4
C5	52	1 1/8
C6	52	7/8
C7	52	3/8
S0	52	5/8
S1	52	1 1/8
S2	52	7/8
S3	52	1 1/8
S4	52	5/8
S5	52	1 1/8
S6	52	7/8

- Notes:
- For Floor Beam Location Diagram see "Floor Beam Details No. 1" sheet.
 - Existing steel railing, curb, walkway and pipe railing not shown.
 - "Typical Section U-U" is typical for all upper floor beam locations except as shown.

NOTE:
THE CONTRACTOR SHALL VERIFY ALL CONTROLLING FIELD DIMENSIONS BEFORE ORDERING OR FABRICATING ANY MATERIAL.

- LEGEND**
- Indicates existing structures.
 - Δ Indicates existing rivets to be removed and replaced with new 1 1/8" ϕ high strength bolts.
 - \circ Indicates approx. location of existing rivets

Notes:


1. For Floor Beam Location Diagram see "Floor Beam Details No. 1" sheet.
2. Existing steel railing, curb, walkway and pipe railing not shown.

DIST.	COUNTY	ROUTE	POST MILES TOTAL PROJECT	SHEET NO.	TOTAL SHEETS
04	SF. A10	80	7.8/8.9, 0.0/1.1	110	205

James S. MacIntyre
REGISTERED ENGINEER - CIVIL
October 22, 1997

12-8-97
PLANS APPROVAL DATE

The State of California or its officers or agents shall not be responsible for the accuracy or completeness of electronic copies of this plan sheet.

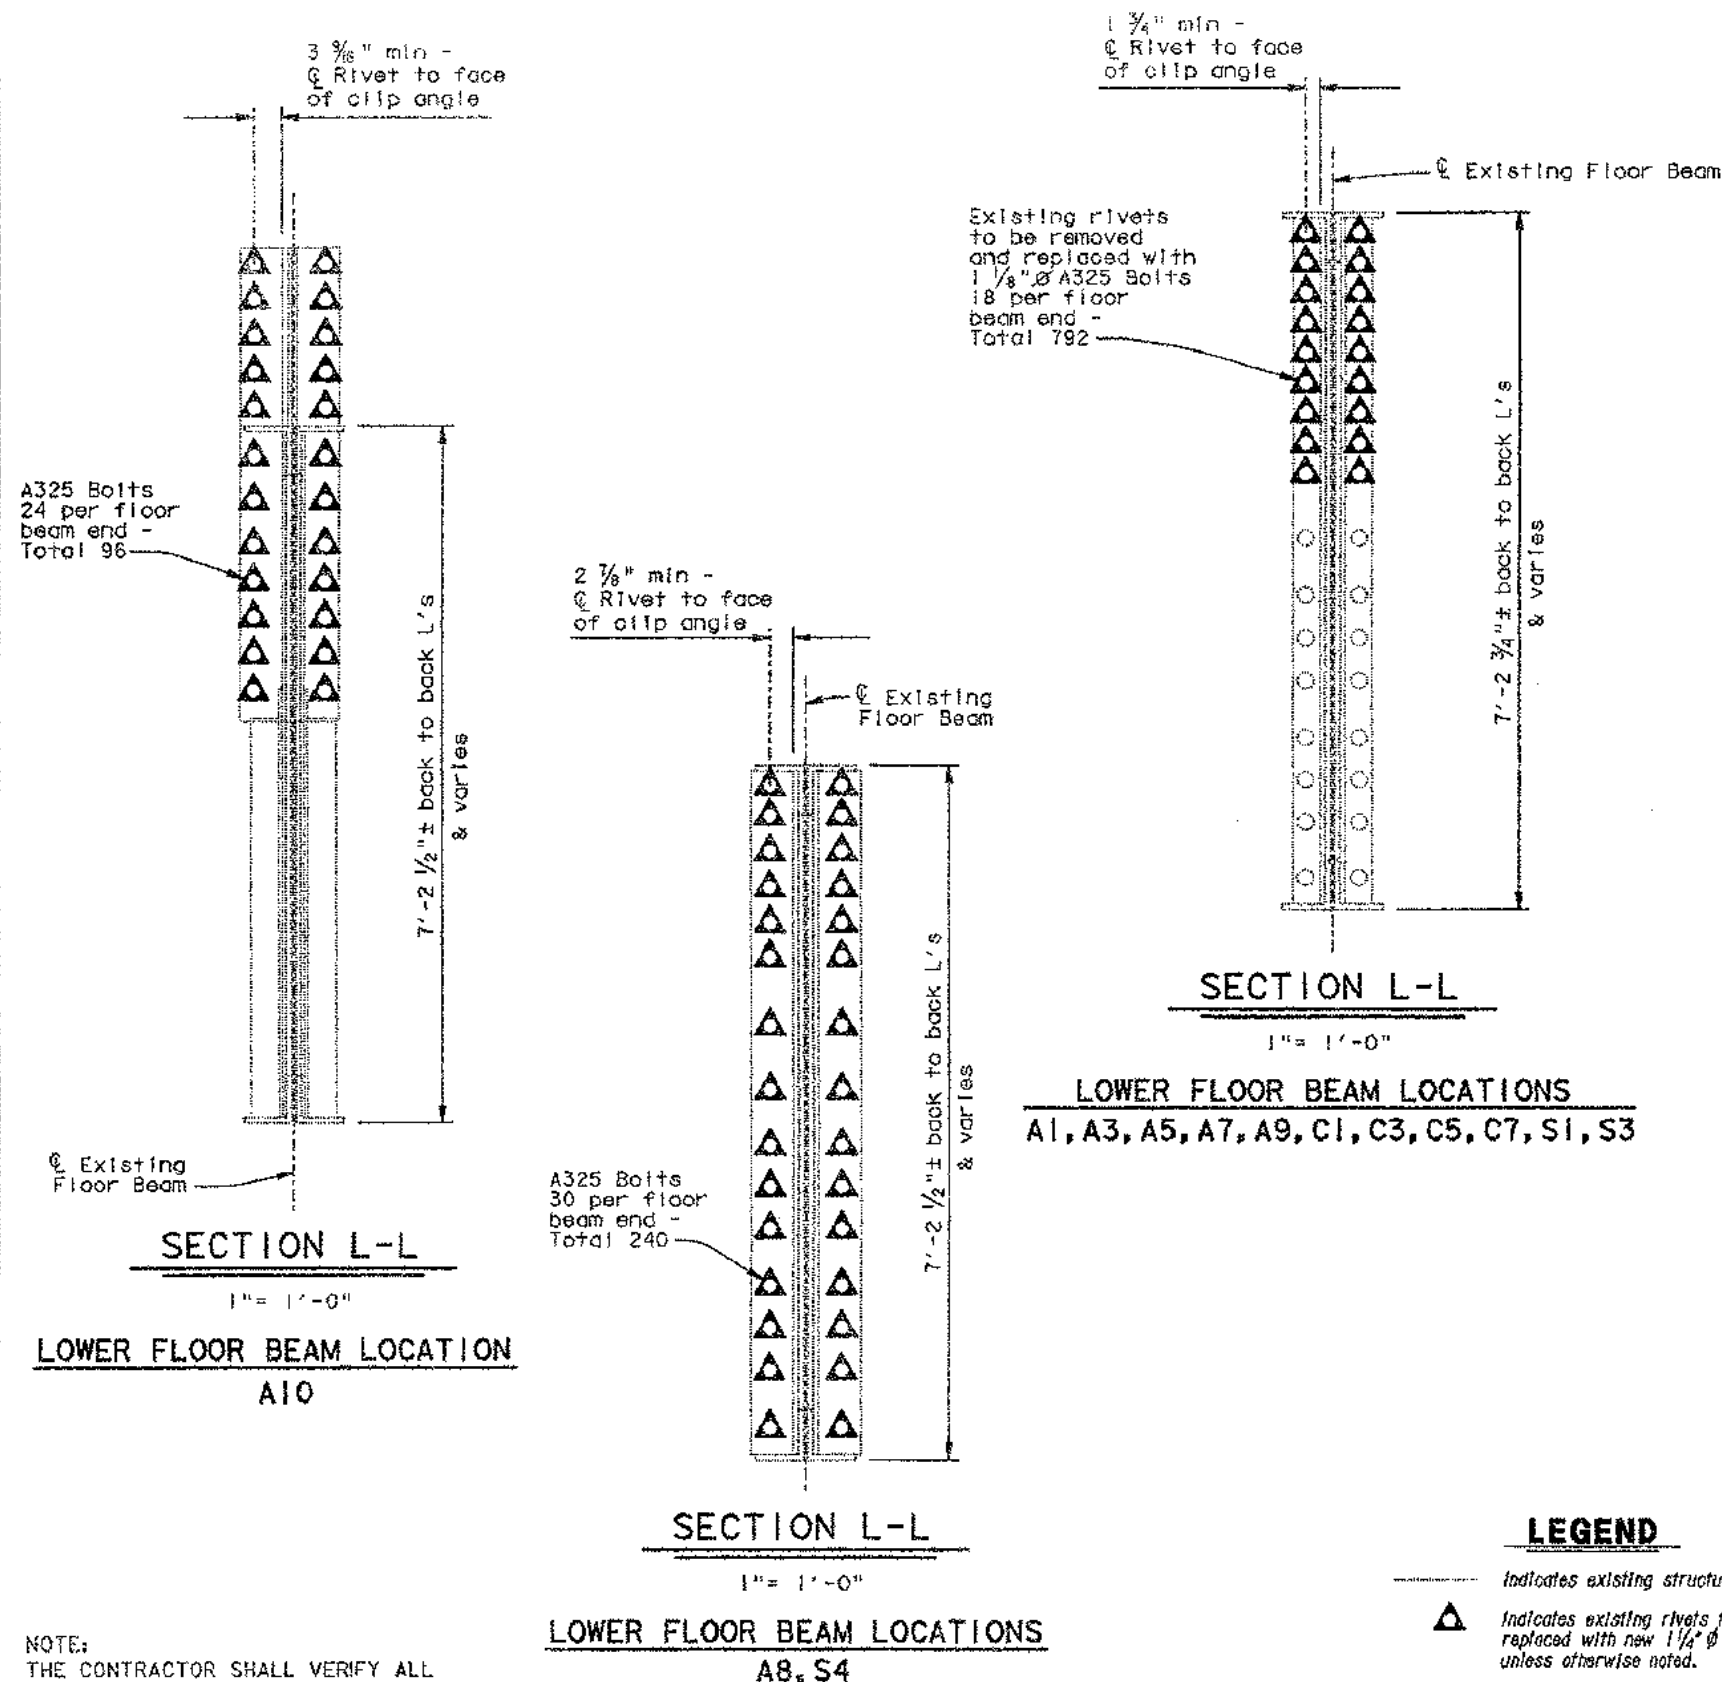

LEGEND

- Indicates existing structures.
- △ Indicates existing rivets to be removed and replaced with new 1 1/4" high strength bolts, unless otherwise noted.
- Indicates approx. location of existing rivets

LOCATION	NUMBER OF RIVETS	APPROXIMATE GRIP LENGTH (Inches)
A10	48	5 1/8
A9	36	1 3/4
A8	32	4 1/16
A8	28	4 7/16
A7	36	2 5/16
A5	36	2 3/8
A4	32	4 1/4
A3	36	2 1/2
A2	32	5 1/8
A1	36	3 3/4
A0	96	6 1/8
A0	128	8 1/8
C1	36	2 3/8
C2	32	3 3/8
C3	36	1 13/16
C4	32	4 5/8
C5	36	1 3/4
C6	32	2 13/16
C7	36	3 1/8
S0	48	3 15/16
S1	36	1 3/4
S2	32	2 1/2
S3	28	1 3/4
S4	28	3 5/16
S4	32	4 3/4
S5	48	7/8
S6	40	4 1/8

NOTE:
THE CONTRACTOR SHALL VERIFY ALL CONTROLLING FIELD DIMENSIONS BEFORE ORDERING OR FABRICATING ANY MATERIAL.

DESIGN BY J. GUNOSTROM 3-97		CHECKED J. MACINTYRE 5-97	STATE OF CALIFORNIA DIVISION OF STRUCTURES STRUCTURE DESIGN TOLL BRIDGE SPECIAL ANALYSIS	BRIDGE NO. 33-0025	INTERIM SEISMIC RETROFIT PROJECT EAST BAY CANTILEVER TRUSS SAN FRANCISCO-OAKLAND BAY BRIDGE FLOOR BEAM DETAILS NO. 3
DETAILS BY P.A. SANDERSON 3-97		CHECKED J. MACINTYRE 5-97		POST MILE 1.15	
QUANTITIES BY P. WATZ 5-97		CHECKED J. SANDERSON/J. MACINTYRE 5-97		DISCARD PRINTS BEARING EARLIER REVISION DATES	


ORIGINAL SCALE IN INCHES FOR REDUCED PLANS

CU 04
EA 043001

REVISION DATES (PRELIMINARY STAGE ONLY)

1	2	3	4	5	6	7	8	9	10

DATE PLOTTED 9-DEC-1997
TIME PLOTTED 08:57

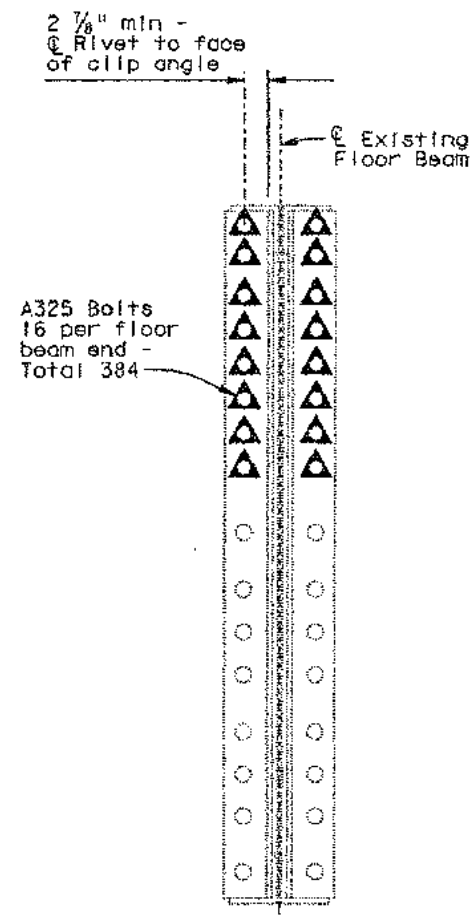


SECTION L-L

1" = 1'-0"

LOWER FLOOR BEAM LOCATIONS

A2, A4, C2, C4, C6, S2

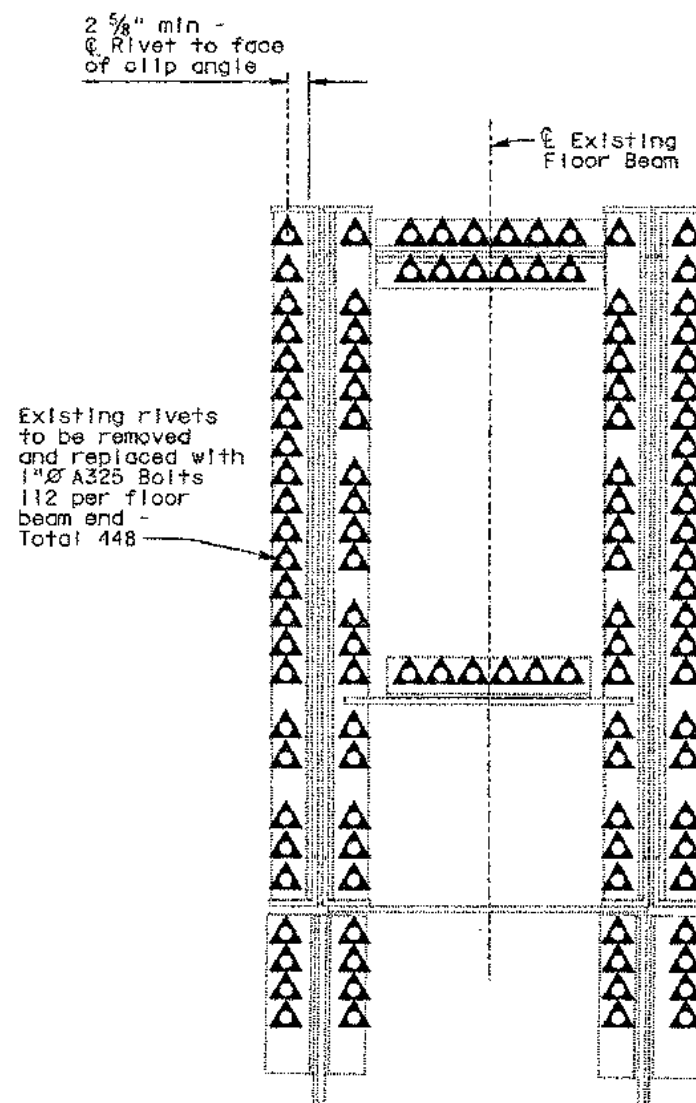


SECTION L-L

1" = 1'-0"

LOWER FLOOR BEAM LOCATIONS

A0

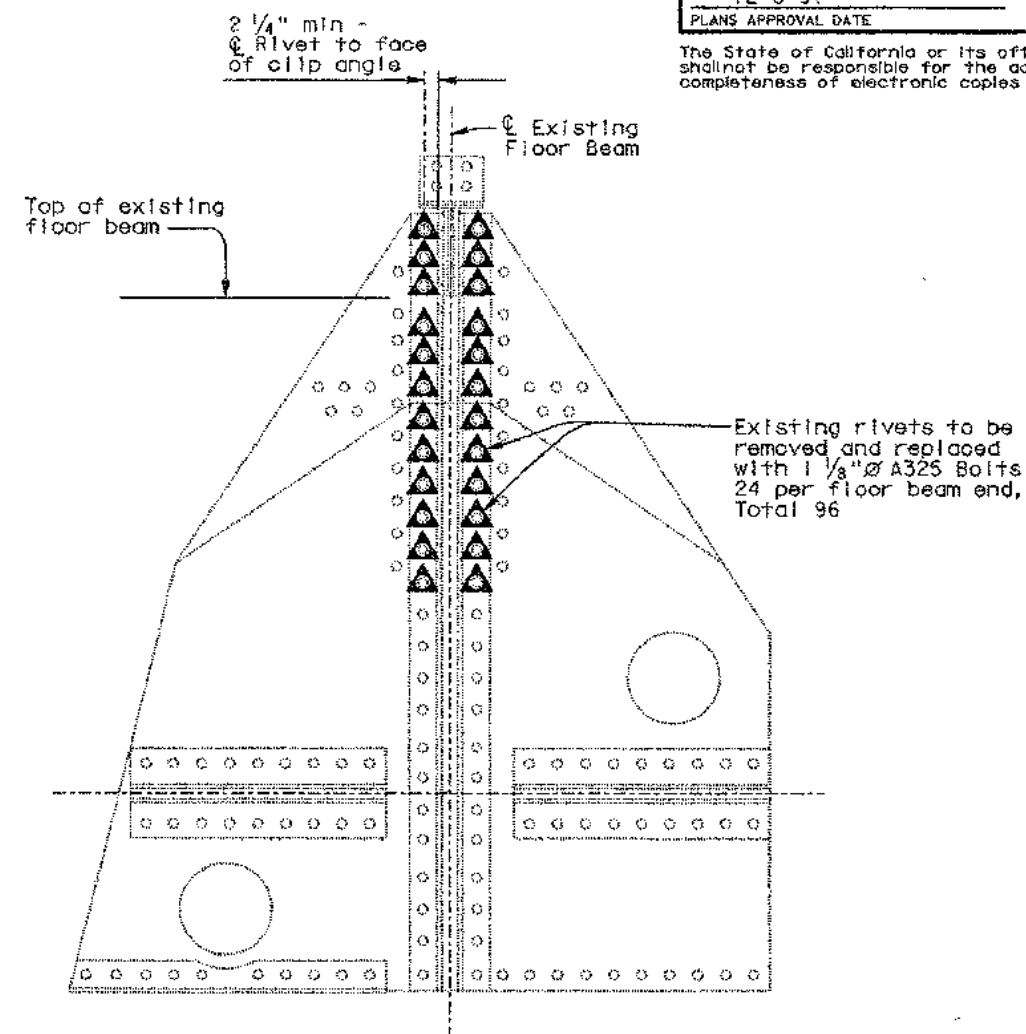

SECTION L-L

1" = 1'-0"

LOWER FLOOR BEAM LOCATIONS

S5

LEGEND

- Indicates existing structures.
- Indicates existing rivets to be removed and replaced with new 1 1/4 inch high strength bolts, unless otherwise noted.
- Indicates approx. location of existing rivets

Notes:

- For Floor Beam Location Diagram see "Floor Beam Details No. 1" sheet
- Existing steel railing, curb, walkway and pipe railing not shown.

NOTE:
THE CONTRACTOR SHALL VERIFY ALL
CONTROLLING FIELD DIMENSIONS
BEFORE ORDERING OR FABRICATING
ANY MATERIAL.

INTERIM SEISMIC RETROFIT PROJECT
EAST BAY CANTILEVER TRUSS
SAN FRANCISCO-OAKLAND BAY BRIDGE
FLOOR BEAM DETAILS NO. 4

DESIGN	BY J. GUNDSYROM 3-97	CHECKED J. MACINTYRE 5-97
DETAILS	BY P.A. SANDERSON 3-97	CHECKED J. MACINTYRE 5-97
QUANTITIES	BY P. WATZ 5-97	CHECKED J. GUNDSYROM/J. MACINTYRE 5-97

STATE OF CALIFORNIA	DIVISION OF STRUCTURES
DEPARTMENT OF TRANSPORTATION	STRUCTURE DESIGN
	TOLL BRIDGE SPECIAL ANALYSIS

BRIDGE NO.	33-0025
POST MILE	1.15


DIST.	COUNTY	ROUTE	POST MILES TOTAL PROJECT	SHEET NO.	TOTAL SHEETS
04	SF, Alameda	80	7.8/8.9. 0.0/1.1	112	205

James S. MacIntyre
 REGISTERED ENGINEER - CIVIL
 October 22, 1997
 12-8-97
 PLANS APPROVAL DATE

The State of California or its officers or agents shall not be responsible for the accuracy or completeness of electronic copies of this plan sheet.

2 7/8" min -
Ø Rivet to
face clip angle

Existing
Floor Beam

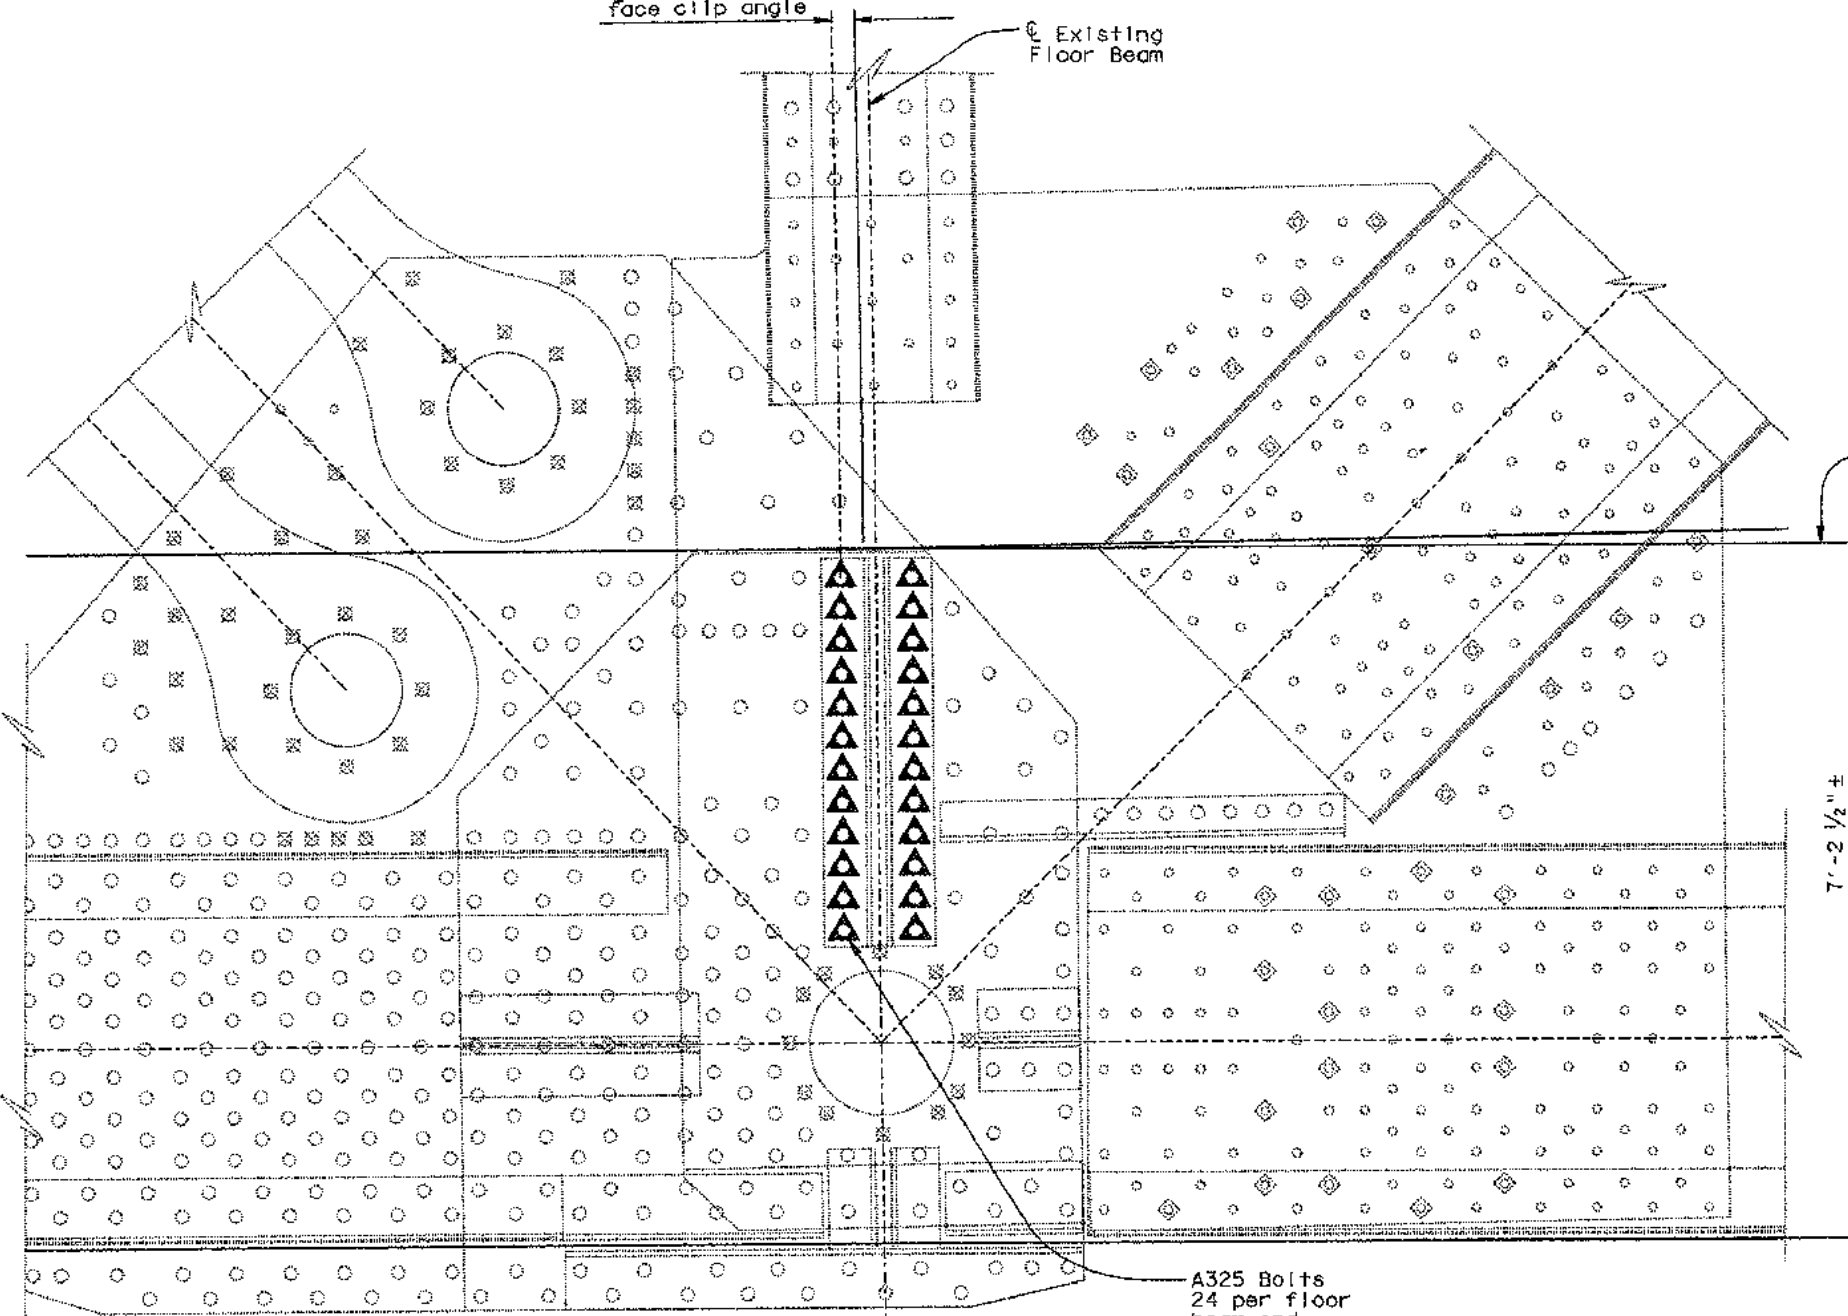

SECTION L-L

1" = 1'-0"

LOWER FLOOR BEAM LOCATIONS

S0

Notes:

- For Floor Beam Location Diagram see "Floor Beam Details No. 1" sheet.
- Existing steel railing, curb, walkway and pipe railing not shown.

NOTE:
THE CONTRACTOR SHALL VERIFY ALL CONTROLLING FIELD DIMENSIONS BEFORE ORDERING OR FABRICATING ANY MATERIAL.

LEGEND


- Indicates existing structures.
- △ Indicates existing rivets to be removed and replaced with new 1 1/4" Ø high strength bolts, unless otherwise noted.
- Indicates approx. location of existing rivets

2 7/8" min -
Ø Rivet to face
of clip angle

Existing
Floor Beam

Existing rivets
to be removed
and replaced with
1 1/4" Ø A325 Bolts
20 per floor
beam end -
Total 40

Top of existing
floor beam

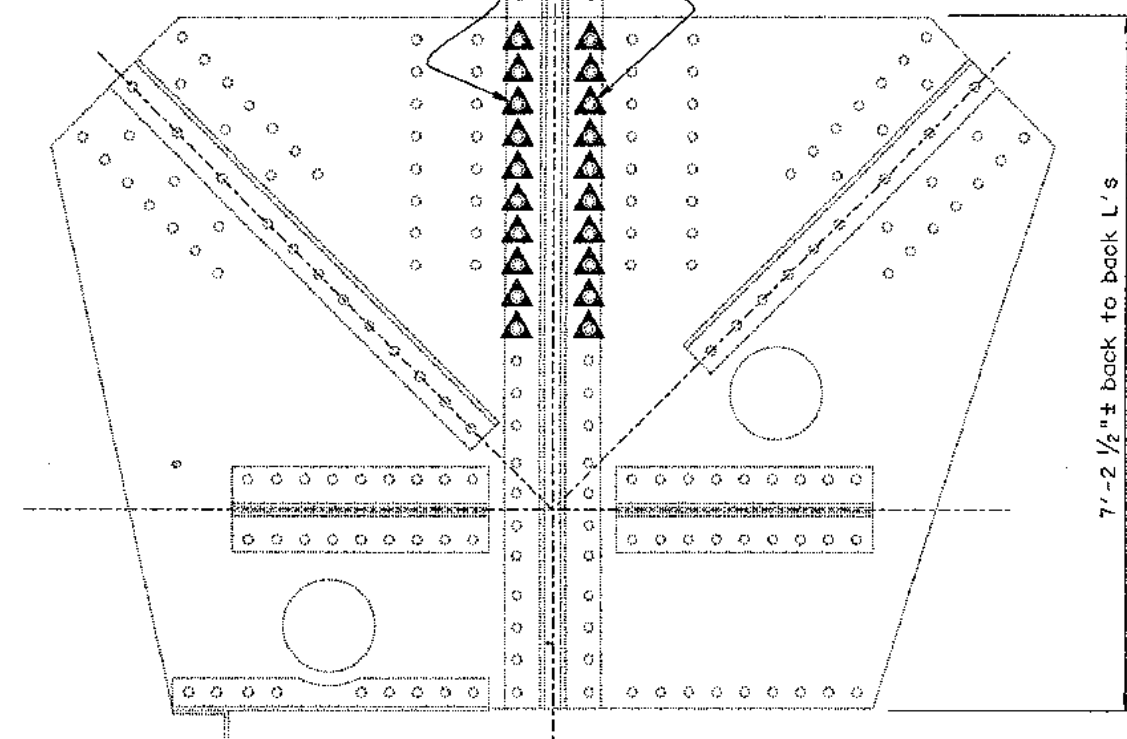

SECTION L-L

1" = 1'-0"

LOWER FLOOR BEAM LOCATION

S6

DESIGN	BY J. GUNDBROM 3-97	CHECKED J. MACINTYRE 5-97
DETAILS	BY D.A. SANDERSON 3-97	CHECKED J. MACINTYRE 5-97
QUANTITIES	BY P. WATZ 5-97	CHECKED J. GUNDBROM/J. MACINTYRE 5-97

STATE OF
CALIFORNIA
DEPARTMENT OF TRANSPORTATION

DIVISION OF STRUCTURES
STRUCTURE DESIGN
TOLL BRIDGE SPECIAL ANALYSIS


BRIDGE NO.
33-0025
POST MILE
1.15

INTERIM SEISMIC RETROFIT PROJECT
EAST BAY CANTILEVER TRUSS
SAN FRANCISCO-OAKLAND BAY BRIDGE
FLOOR BEAM DETAILS NO. 5

CU 04
EA 043001


DISREGARD PRINTS BEARING
EARLIER REVISION DATES
REVISION DATES (PRELIMINARY STAGE ONLY)
22/97 5/97 6/97
USERNAME => trph115
cch5 09024530

SHEET 8 OF 18

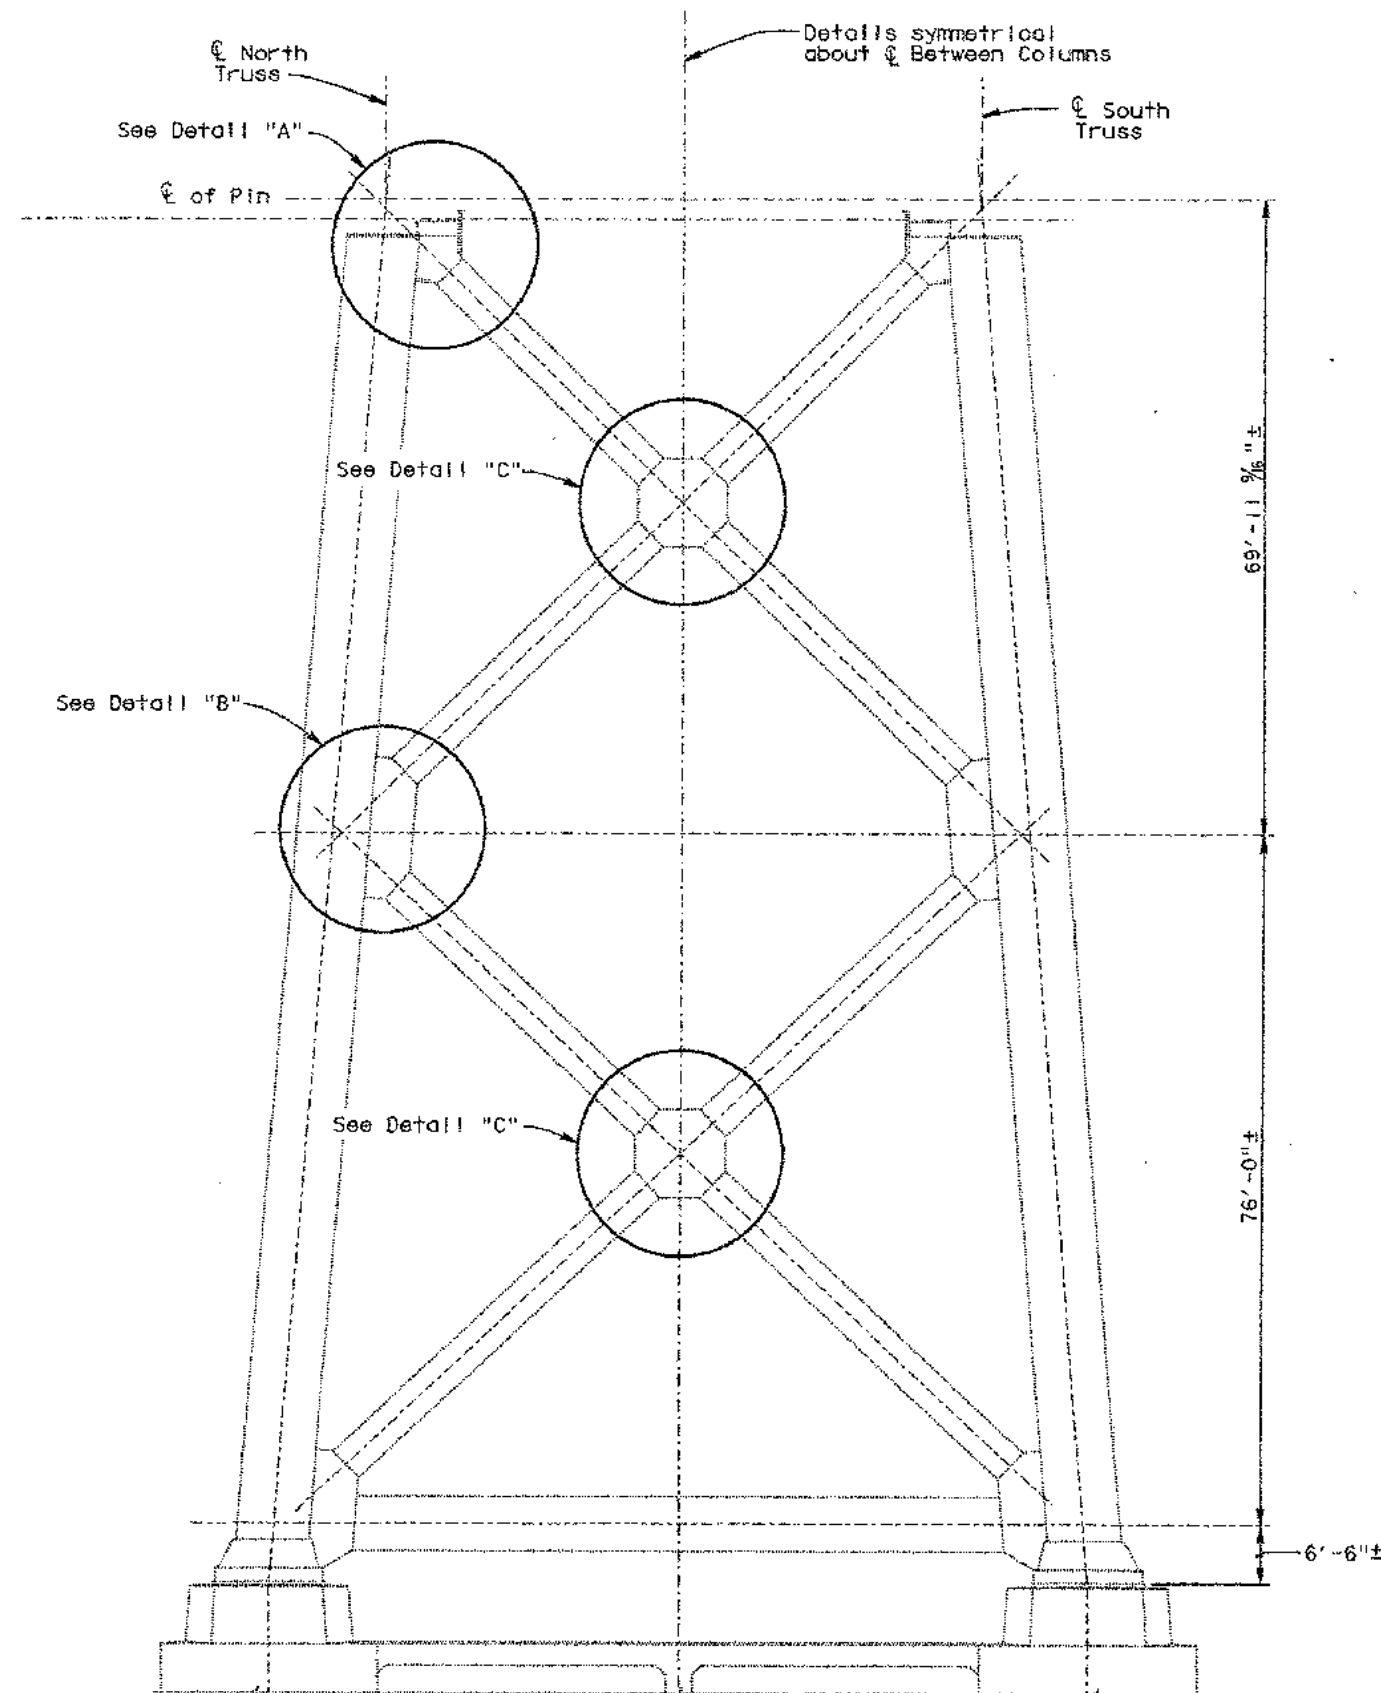

NOTE:
THE CONTRACTOR SHALL VERIFY ALL
CONTROLLING FIELD DIMENSIONS
BEFORE ORDERING OR FABRICATING
ANY MATERIAL.

PART ELEVATION
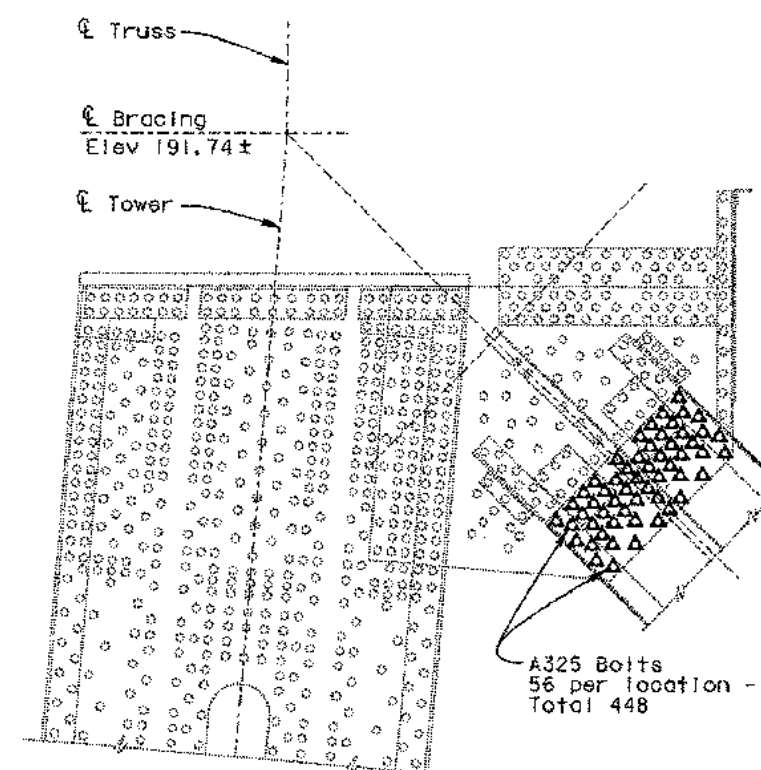
$$\frac{3}{2} \cdot 16 = 1' - 0''$$


DETAIL "A"

$$\frac{1}{2}'' = 1' - 0''$$


TOWERS E2, E3 & E4

INSTALLATION NOTES:

1. Rivet replacement with HS bolts shall begin with the center-most rivets in any given member-end and continue outward in a concentric pattern. No more than 25% of the total rivets to be replaced in a single face of any single member end may be worked on at one time.
2. Only one member-end per gusset shall be worked on at one time and must be completed before work commences on any additional member-ends within the same gusset.
3. Only one face of a gusset shall be worked on at any one time.
4. All HS bolts shall be fully tensioned prior to removing any additional rivets.
5. New HS bolts shall be the same size, or larger as required, as the rivets being replaced.
6. Rivets which cannot be removed without damaging the adjacent steel shall be cored out, leaving a hole $\frac{3}{16}$ " larger in diameter than the diameter of the removed rivet. The new HS bolt shall have a diameter which is $\frac{1}{16}$ " smaller than the cored hole.

DIST.	COUNTY	ROUTE	POST MILES TOTAL PROJECT	SHEET NO.	TOTAL SHEETS
04	SF, A10	80	7.8/8.9. 8.0/1.1	113	205

James S. MacLachlan
REGISTERED ENGINEER - CIVIL
October 22, 1999

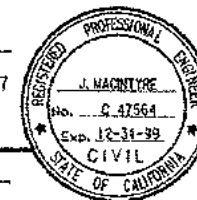


12-8-97
PLANS APPROVAL DATE

The State of California or its officers or agents shall not be responsible for the accuracy or completeness of electronic copies of this plan sheet.

DETAIL "A"	
Number Per Location	Approximate Grip Length (Inches)
12	2 1/16
6	1 3/4
38	1 3/8

LEGEND

... indicates existing structures.

 Indicates existing rivets to be removed and replaced with new 1" Ø high strength bolts.

○ Indicates approx. location of existing rivets

Notes:

1. Pier E2 shown, Pier E3 similar.
2. For Detail "B" & Detail "C" see "Piers E2, E3 Details No. 2" sheet.

DESIGN	BY J. GUNSTROM 3-97	CHECKED J. MACINTYRE 5-97
DETAILS	BY D.A. SANDERSON 3-97	CHECKED J. MACINTYRE 5-97
QUANTITIES	BY J. MACINTYRE 5-97	CHECKED J. GUNSTROM 5-97

STATE OF
CALIFORNIA
DEPARTMENT OF TRANSPORTATION

**DIVISION OF STRUCTURES
STRUCTURE DESIGN**


BRIDGE NO.	33-002
POST MILE	1.15

INTERIM SEISMIC RETROFIT PROJECT
EAST BAY CANTILEVER TRUSS
SAN FRANCISCO-OAKLAND BAY BRIDGE
PIERS E2,E3 DETAILS NO. 1

DIST.	COUNTY	ROUTE	POST MILES TOTAL PROJECT	SHEET NO.	TOTAL SHEETS
04	SF. A10	80	7.8/8.9, 0.0/1.1	114	205
James S. MacIntyre REGISTERED ENGINEER - CIVIL October 22, 1997			No. C 47584 Exp. 12-31-99 CIVIL STATE OF CALIFORNIA		
12-8-97 PLANS APPROVAL DATE					


The State of California or its officers or agents shall not be responsible for the accuracy or completeness of electronic copies of this plan sheet.

DETAIL "B" - UPPER	
Number Per Location	Approximate Grip Length (Inches)
16	1 13/16
44	1 3/8

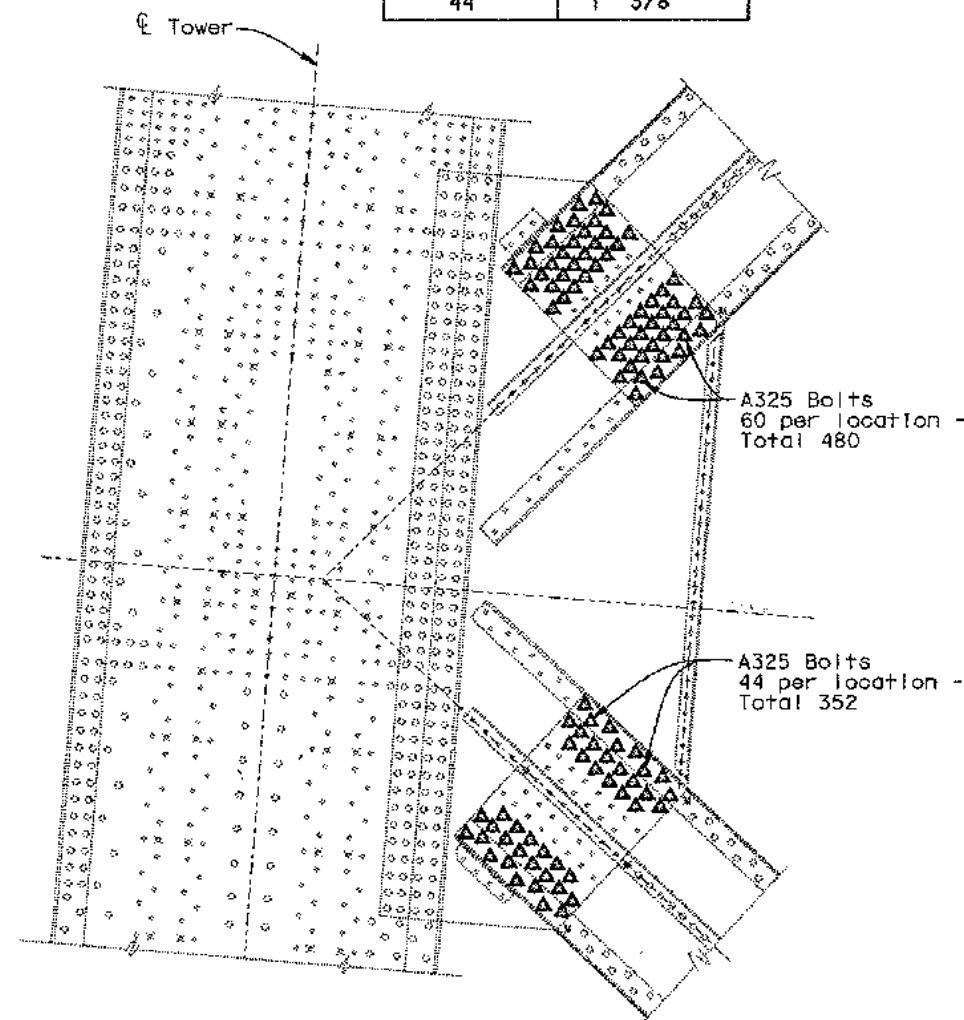

DETAIL "B"
1/2" = 1'-0"

DETAIL "B" - LOWER	
Number Per Location	Approximate Grip Length (Inches)
16	2 1/16
28	1 3/8

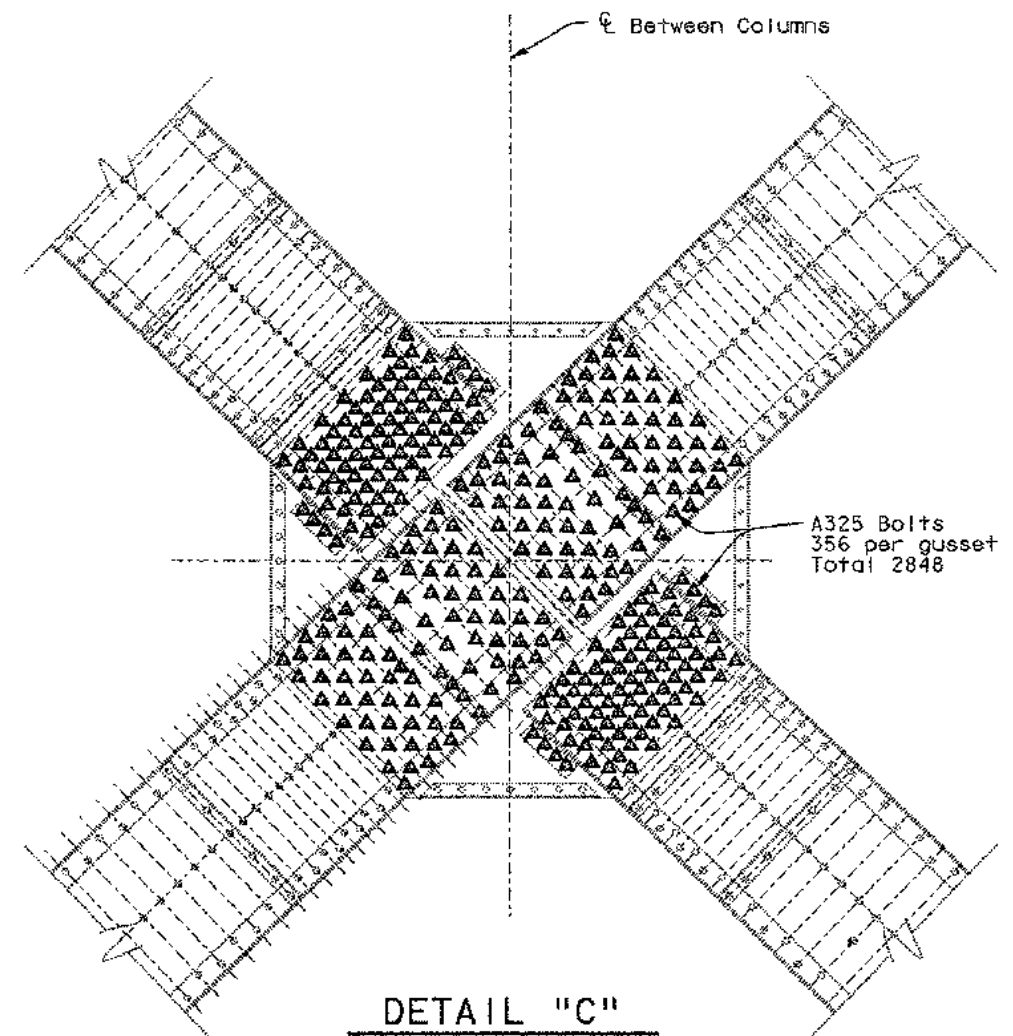

DETAIL "C"
1/2" = 1'-0"

DETAIL "C"	
Number Per Location	Approximate Grip Length (Inches)
160	2 1/16
36	2 7/16
32	1 13/16
128	1 3/8

Note:

- For location of Detail "B" & Detail "C" see "Piers E2,E3 Details No. 1" sheet.

NOTE:


THE CONTRACTOR SHALL VERIFY ALL CONTROLLING FIELD DIMENSIONS BEFORE ORDERING OR FABRICATING ANY MATERIAL.

LEGEND

- Indicates existing structures.
- Indicates existing rivets to be removed and replaced with new 1" high strength bolts.
- Indicates approx. location of existing rivets.


INTERIM SEISMIC RETROFIT PROJECT
EAST BAY CANTILEVER TRUSS
SAN FRANCISCO-OAKLAND BAY BRIDGE
PIERS E2,E3 DETAILS NO. 2

DESIGN	BY J. SUNDBROM 3-97	CHECKED J. MACINTYRE 5-97	STATE OF CALIFORNIA	DIVISION OF STRUCTURES	BRIDGE NO. 33-0025
DETAILS	BY D.A. SANDERSON 3-97	CHECKED J. MACINTYRE 5-97	DEPARTMENT OF TRANSPORTATION	STRUCTURE DESIGN	POST MILE 1.15
QUANTITIES	BY J. MACINTYRE 5-97	CHECKED J. SUNDBROM 5-97		TOLL BRIDGE SPECIAL ANALYSIS	
ORIGINAL SCALE IN INCHES FOR REDUCED PLANS			CU 04 EA 043001	DISREGARD PRINTS BEARING EARLIER REVISION DATES	
			REVISION DATES (PRELIMINARY STAGE ONLY)		SHEET 10 OF 18

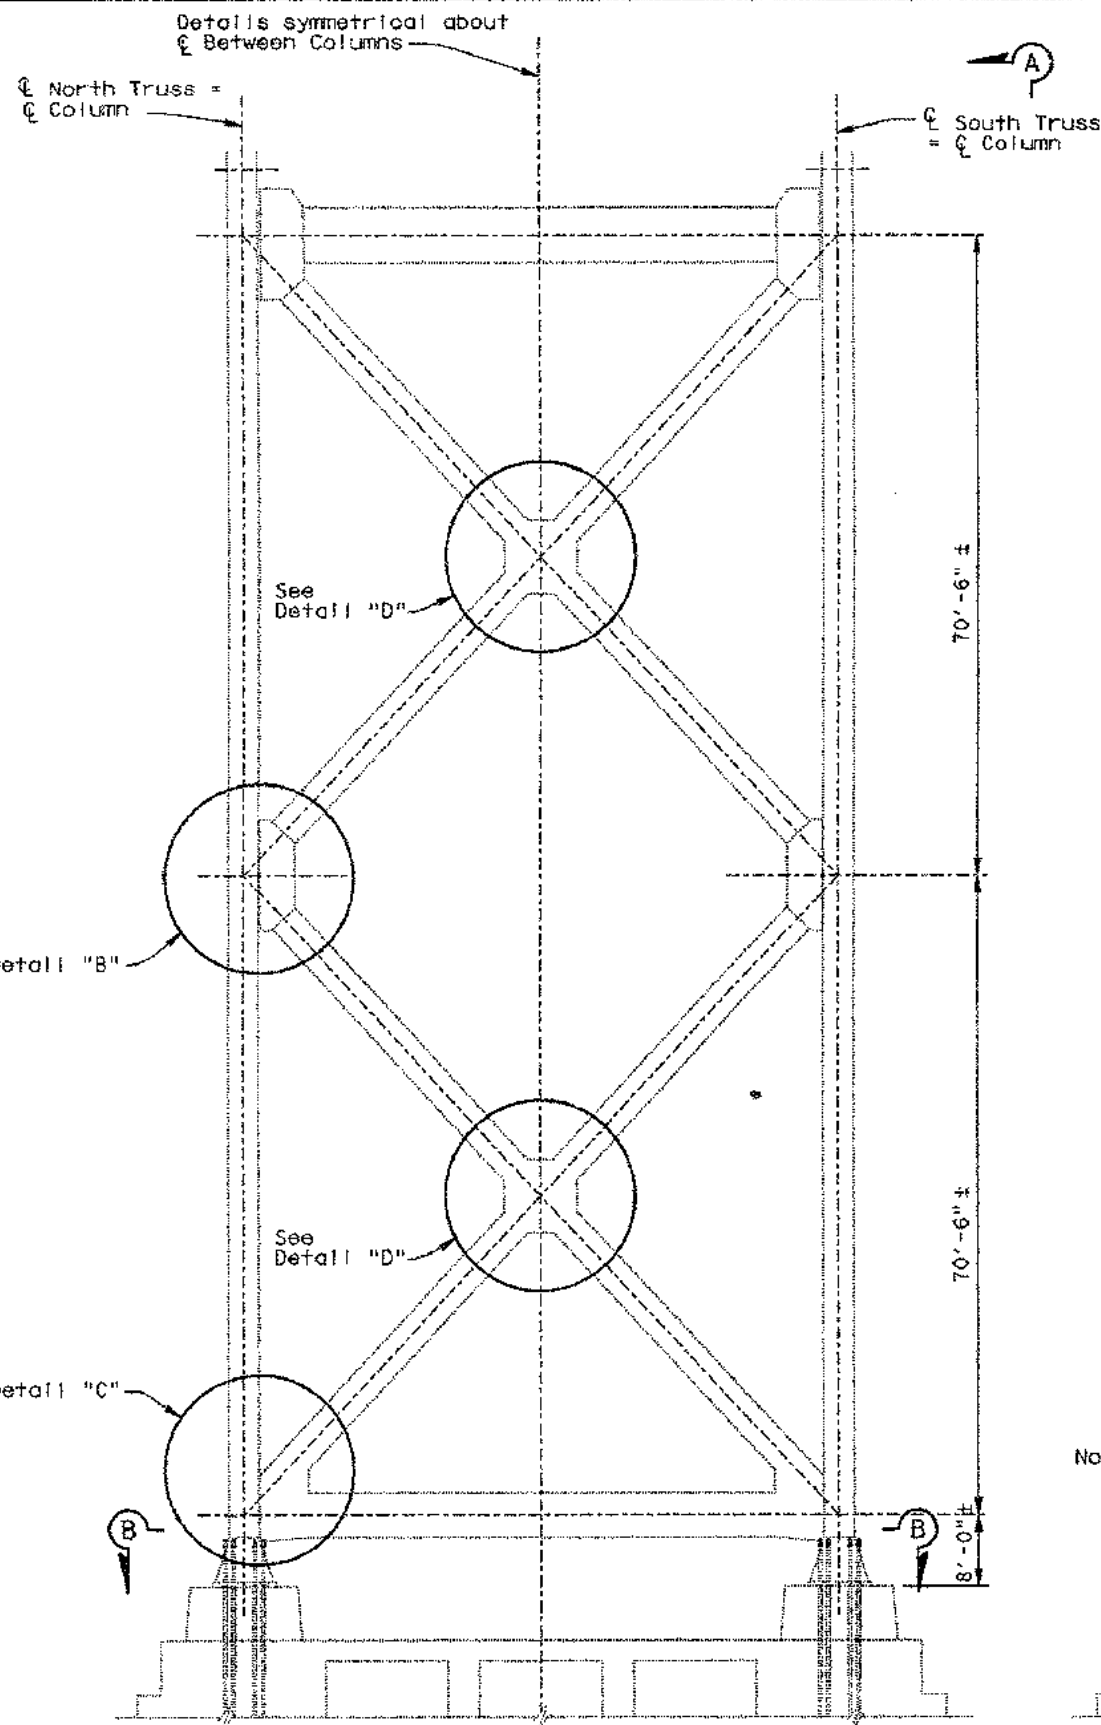

PART ELEVATION

$\frac{1}{32}'' = 1'-0''$

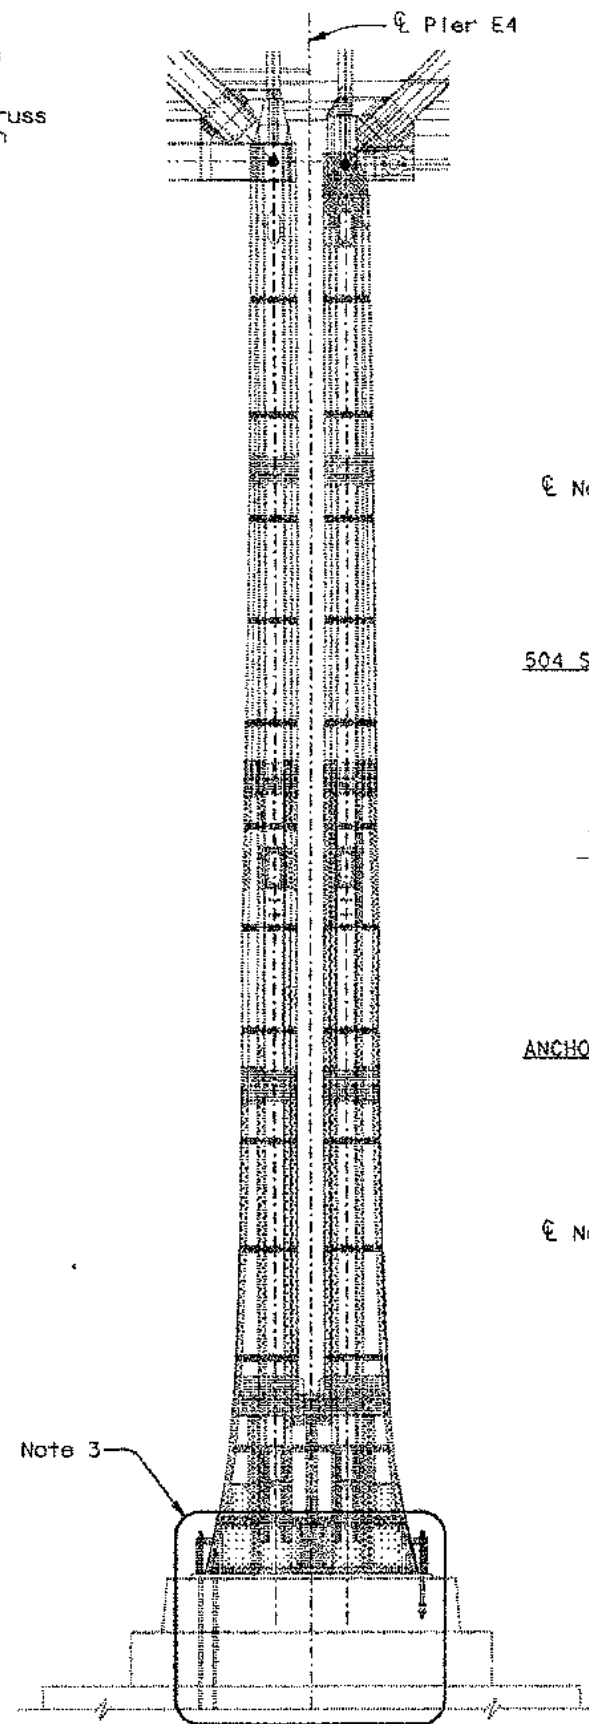

VIEW A-A


$\frac{1}{32}'' = 1'-0''$

LEGEND

Indicates existing structures.

Indicates existing rivets to be removed and replaced with new 1" Ø high strength bolts.

Indicates approx. location of existing rivets

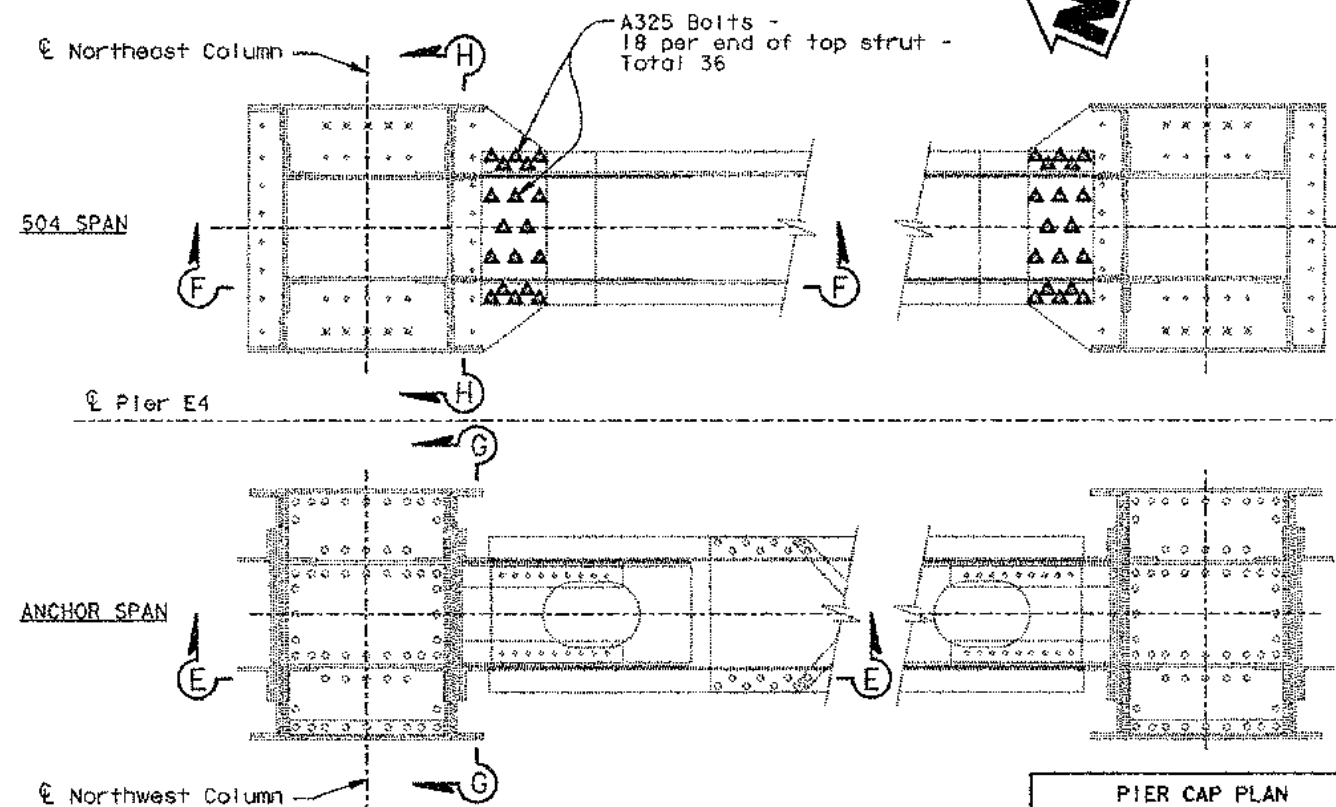

PIER CAP PLAN

$\frac{1}{2}'' = 1'-0''$

PIER CAP PLAN	
Number Per Location	Approximate Grip Length (Inches)
20	3 13/16
16	3 5/16

Notes:

- For Detail "B", Detail "C" and Detail "D" see "Pier E4 Details No. 2" sheet.
- For Sections E-E, F-F, G-G and H-H see "Pier E4 Details No. 3" sheet.
- For base of tower retrofit details see "Pier E4 Details No. 4 and No. 5" sheets.
- For Pier E4 shop drawings reference see "Pier E4 Details No. 2" sheet.

NOTE:
THE CONTRACTOR SHALL VERIFY ALL CONTROLLING FIELD DIMENSIONS BEFORE ORDERING OR FABRICATING ANY MATERIAL.

INTERIM SEISMIC RETROFIT PROJECT
EAST BAY CANTILEVER TRUSS
SAN FRANCISCO-OAKLAND BAY BRIDGE
PIER E4 DETAILS NO. 1

DESIGN	BY J. LYNCH	3-97	CHECKED J. SUNDBLOM	5-97
DETAILS	BY D.A. SANDERSON	3-97	CHECKED J. SUNDBLOM	5-97
QUANTITIES	BY J. LYNCH	5-97	CHECKED J. SUNDBLOM	5-97

STATE OF CALIFORNIA
DEPARTMENT OF TRANSPORTATION
DIVISION OF STRUCTURES
STRUCTURE DESIGN
TOLL BRIDGE SPECIAL ANALYSIS

BRIDGE NO.
33-0025
POST MILE
1.15

DIST.	COUNTY	ROUTE	POST MILES TOTAL PROJECT	SHEET NO.	TOTAL SHEETS
04	SF, Alameda	80	7.8/8.9, 0.0/1.1	116	205
<div>James S. MacIntyre REGISTERED ENGINEER - CIVIL October 22, 1997</div> <div>12-8-97 PLANS APPROVAL DATE</div> <div>PROFESSIONAL ENGINEER J. MACINTYRE No. C-47564 Exp. 12-31-99 CIVIL STATE OF CALIFORNIA</div>					

The State of California or its officers or agents shall not be responsible for the accuracy or completeness of electronic copies of this plan sheet.

DETAIL "C"	
Number Per Location	Approximate Grip Length (Inches)
112	1 1/2
56	1 7/16
176	1

A325 Bolts
114 per gusset -
Total 912

DETAIL "B"	
Number Per Location	Approximate Grip Length (Inches)
272	1 1/2
128	1 7/16
512	1

A325 Bolts
43 per gusset -
Total 344

DETAIL "B"

1/2" = 1'-0"

DETAIL "D"	
Number Per Location	Approximate Grip Length (Inches)
224	1 1/2
112	1 7/16
352	1

DETAIL "D"

1/2" = 1'-0"

DETAIL "C"

1/2" = 1'-0"

A325 Bolts
86 per gusset -
Total 688

LEGEND

Indicates existing structures.

Indicates existing rivets to be removed and replaced with new 3/8" high strength bolts.

Indicates approx. location of existing rivets

NOTE:
THE CONTRACTOR SHALL VERIFY ALL CONTROLLING FIELD DIMENSIONS BEFORE ORDERING OR FABRICATING ANY MATERIAL.

Note:
1. For location of Detail "B", Detail "C" and Detail "D" see "Pier E4 Details No. 1" sheet.

INTERIM SEISMIC RETROFIT PROJECT



EAST BAY CANTILEVER TRUSS

SAN FRANCISCO-OAKLAND BAY BRIDGE


PIER E4 DETAILS NO. 2

The State of California or its officers or agents shall not be responsible for the accuracy or completeness of electronic copies of this plan sheet.

SECTION E-E	
Number Per Location	Approximate Grip Length (Inches)
204	1 7/16
112	1 5/16
28	1 3/8
88	1

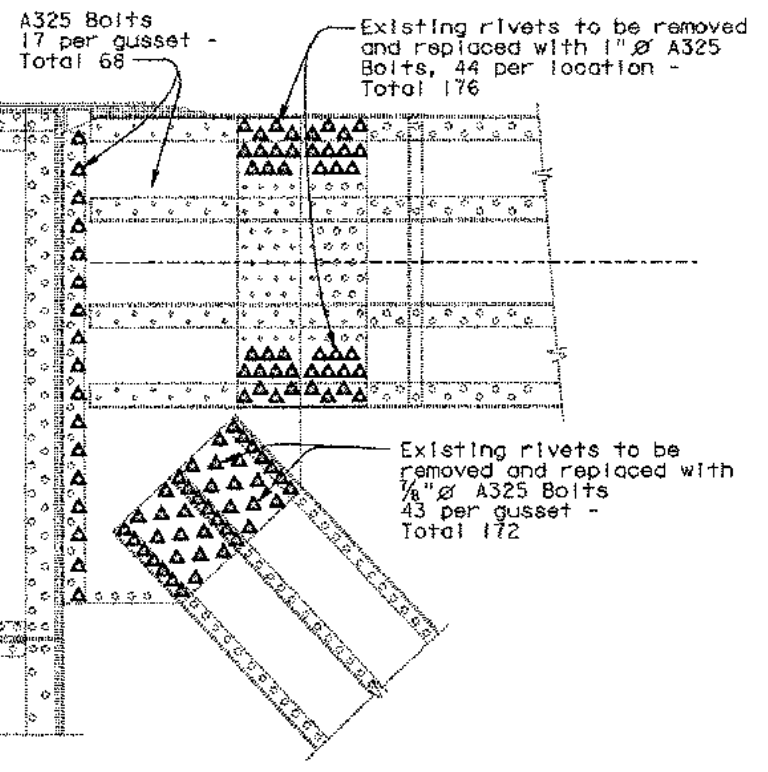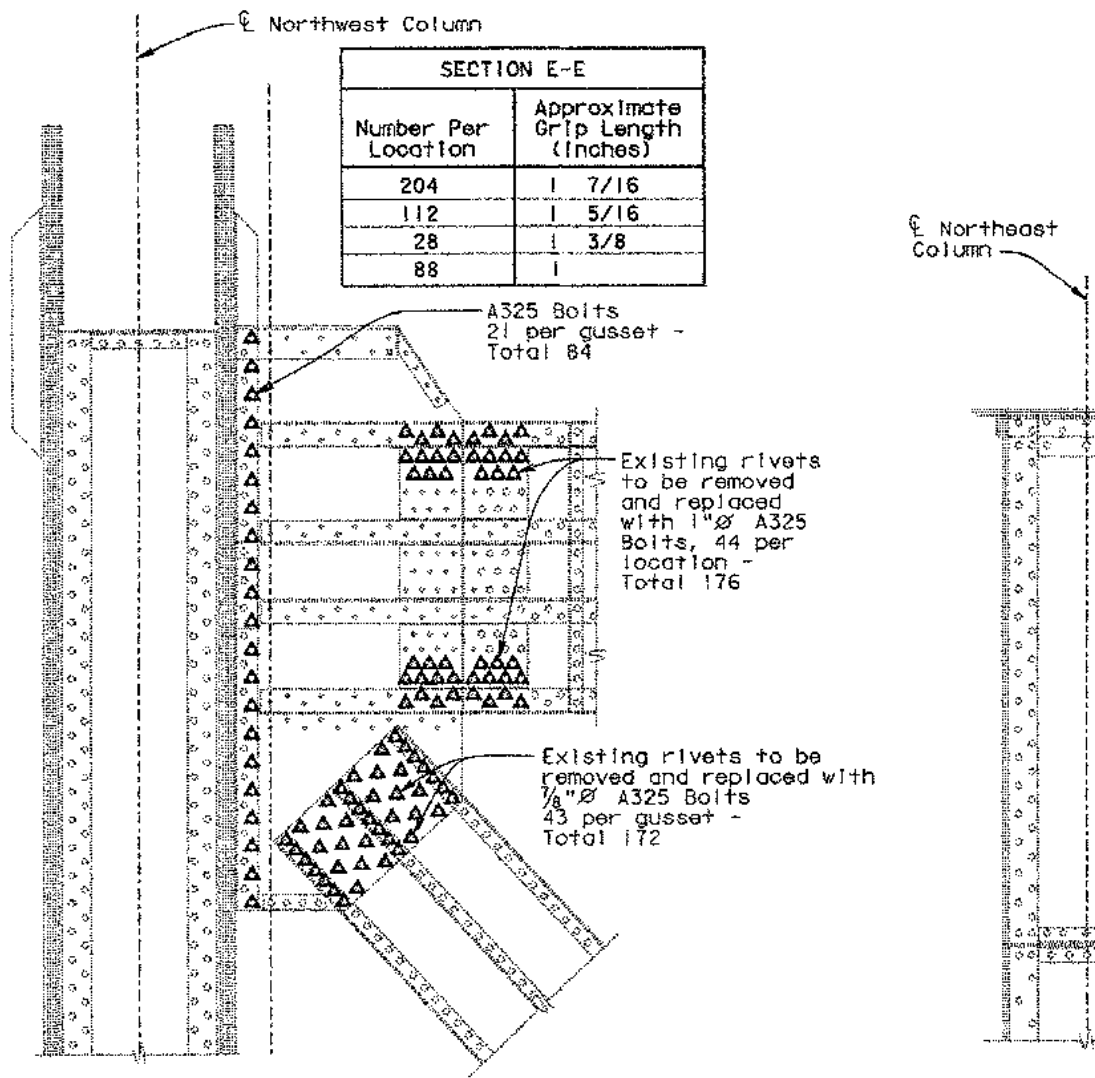

SECTION H-H	
Number Per Location	Approximate Grip Length (Inches)
32	1 3/4
12	3 1/4

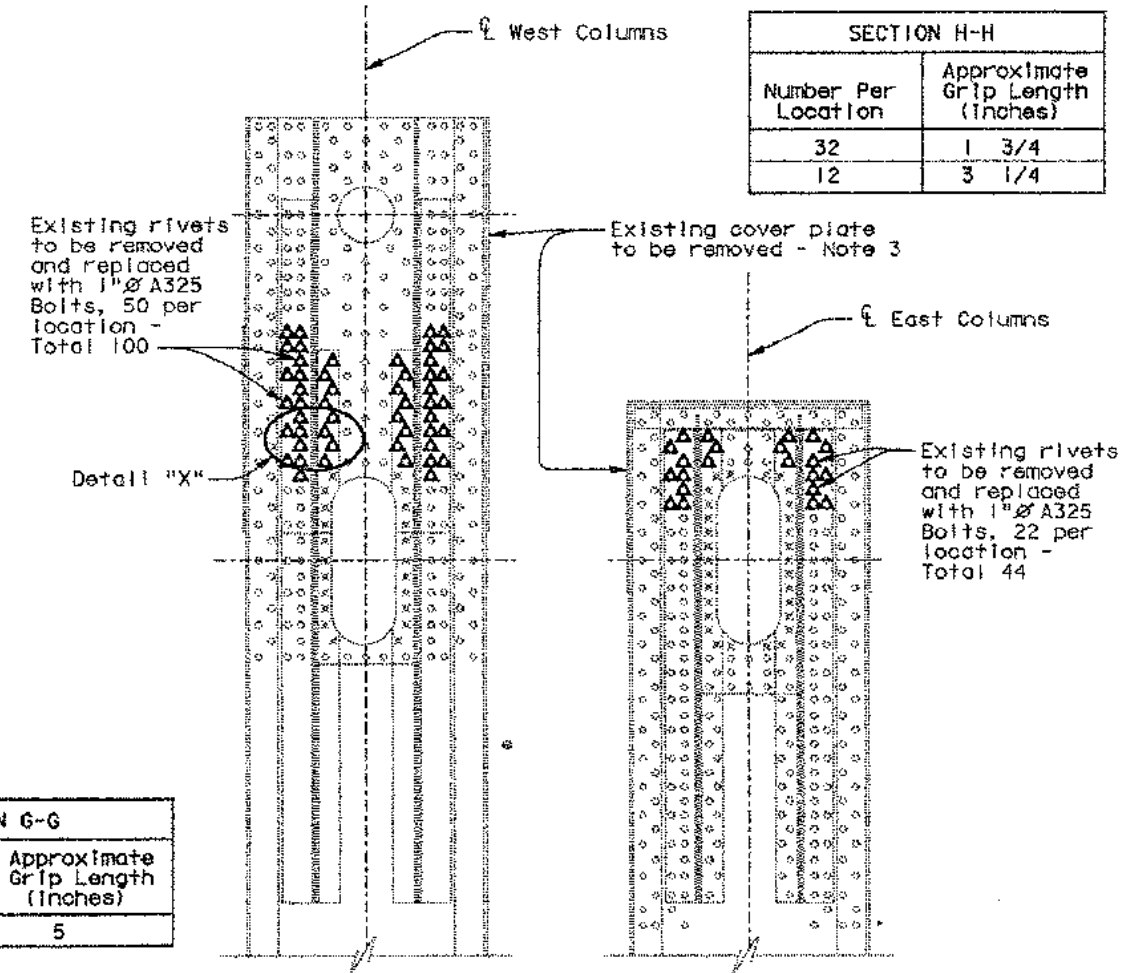

SECTION E-E
1/2" = 1'-0"



SECTION F-F	
Number Per Location	Approximate Grip Length (Inches)
188	1 7/16
112	1 5/16
28	1 3/8
88	1

SECTION F-F
1/2" = 1'-0"

SECTION G-G	
Number Per Location	Approximate Grip Length (Inches)
100	5

SECTION G-G
1/2" = 1'-0"

SECTION H-H
1/2" = 1'-0"

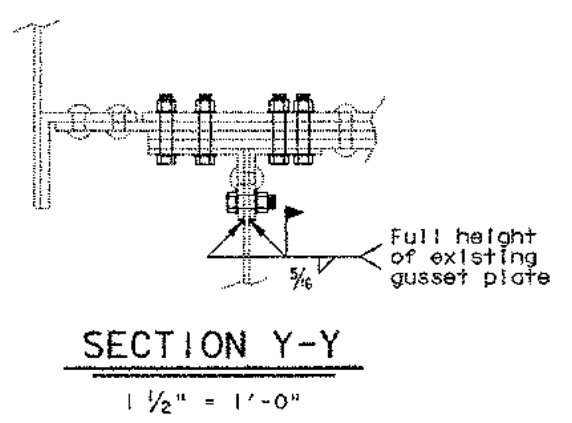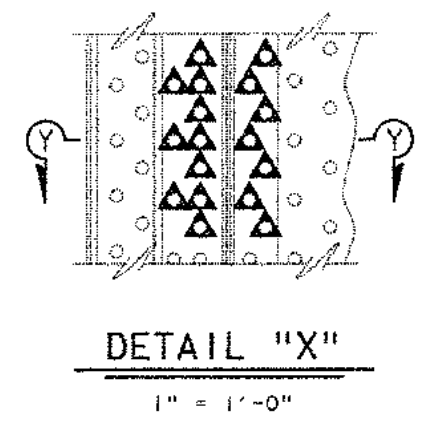

- Notes:
- For location of Sections E-E, F-F, G-G and H-H see "Pier E4 Details No. 1" sheet.
 - Superstructure not shown
 - For limits of cover plate removal see "Pier E4 Tower Bumper Details No. 2 and No. 3" sheets.

- LEGEND
- Indicates existing structures.
 - Indicates existing rivets to be removed and replaced with new 1 1/8" high strength bolts, unless otherwise noted.
 - Indicates approx. location of existing rivets

NOTE:
THE CONTRACTOR SHALL VERIFY ALL CONTROLLING FIELD DIMENSIONS BEFORE ORDERING OR FABRICATING ANY MATERIAL.

INTERIM SEISMIC RETROFIT PROJECT
EAST BAY CANTILEVER TRUSS
SAN FRANCISCO-OAKLAND BAY BRIDGE
PIER E4 DETAILS NO. 3

DESIGN	BY J. LYNCH 3-97	CHECKED J. SUNDSTROM 5-97	STATE OF CALIFORNIA	DIVISION OF STRUCTURES	BRIDGE NO. 33-0025
DETAILS	BY D.A. SANDERSON 3-97	CHECKED J. SUNDSTROM 5-97	DEPARTMENT OF TRANSPORTATION	STRUCTURE DESIGN	POST MILE 1.15
QUANTITIES	BY J. LYNCH 5-97	CHECKED J. SIEMERS 5-97		TOLL BRIDGE SPECIAL ANALYSIS	

ORIGINAL SCALE IN INCHES FOR REDUCED PLANS

CU 04
EA 043001

DISREGARD PRINTS BEARING EARLIER REVISION DATES

REVISION DATES (PRELIMINARY STAGE ONLY)

5-29-97	5-29-97	5-29-97	5-29-97	5-29-97
---------	---------	---------	---------	---------

SHEET 13 OF 18

USERNAME -> trpn115

}

}

}

capire43_09084r13

}

Details symmetrical about C-Pier E4 except as shown

Anchor Span

504' Span

11'-6" ±

11'-6" ±

33'-0" ±

Details symmetrical about
C Between Columns

Note 4

Existing concrete
tower pedestal

PART PLAN

Exterior
Cored Hole

3" Min Cir

1/2" = 1'-0"

Details symmetrical
about C-Pier E4 except as shown

4 Anchor Brackets
each location -
Total 32

Top of bearing
plate - Elev 34.75
West Side

Detail "J"

4'-8" ±
West

Double-nut this end of
each anchor bolt with
heavy hex nuts

Top of bearing
plate - Elev 32.50
East Side

2'-6" ±
East

Top of existing
concrete tower
pedestal -
Elev 30.0 ±

11'-0" ± Length for payment
4" Ø cored holes, typical

PART ELEVATION (LOOKING NORTH)

1/2" = 1'-0"

Heavy Hex
Nut, typ

Bottom of
Cored Holes

6" max
typ

2" Ø Anchor Bolt
threaded each end.
Grout in 4" Ø cored hole
Total 32

LEGEND

Indicates existing structures.

● Indicates new High strength bolts.

○ Indicates approx. location of existing rivets

Notes:

1. For Detail "J" and Section K-K see "Pier E4 Details No. 5" sheet
2. For details not shown see "Pier E4 Details No. 5" sheet
3. Existing rivet heads behind the new anchor brackets shall be ground flush with the surrounding plate.
4. Existing rivet heads inside the column shall be ground flush with the surrounding plate when interference occurs with new anchor bracket bolts.
5. Surfaces of cored holes shall be roughened to 1/4" amplitude.

NOTE:
THE CONTRACTOR SHALL VERIFY ALL
CONTROLLING FIELD DIMENSIONS
BEFORE ORDERING OR FABRICATING
ANY MATERIAL.

INTERIM SEISMIC RETROFIT PROJECT
EAST BAY CANTILEVER TRUSS
SAN FRANCISCO-OAKLAND BAY BRIDGE
PIER E4 DETAILS NO. 4

DESIGN	BY J. LYNCH	3-97	CHECKED J. SUNDBY	5-97
DETAILS	BY D.A. SANDERSON	3-97	CHECKED J. SUNDBY	5-97
QUANTITIES	BY J. LYNCH	5-97	CHECKED J. SUNDBY	5-97


STATE OF CALIFORNIA	DIVISION OF STRUCTURES
DEPARTMENT OF TRANSPORTATION	STRUCTURE DESIGN
	TOLL BRIDGE SPECIAL ANALYSIS

BRIDGE NO.	33-0025
POST MILE	1.15

DISCARD PRINTS BEARING
EARLIER REVISION DATES

REVISION DATES (PRELIMINARY STAGE ONLY)	SHEET	OF
2-20-97 3-2-97 5-2-97 5-30-97 5-31-97 5-31-97 6-10-97 6-20-97 10-2-97	14	18

The State of California or its officers or agents shall not be responsible for the accuracy or completeness of electronic copies of this plan sheet.

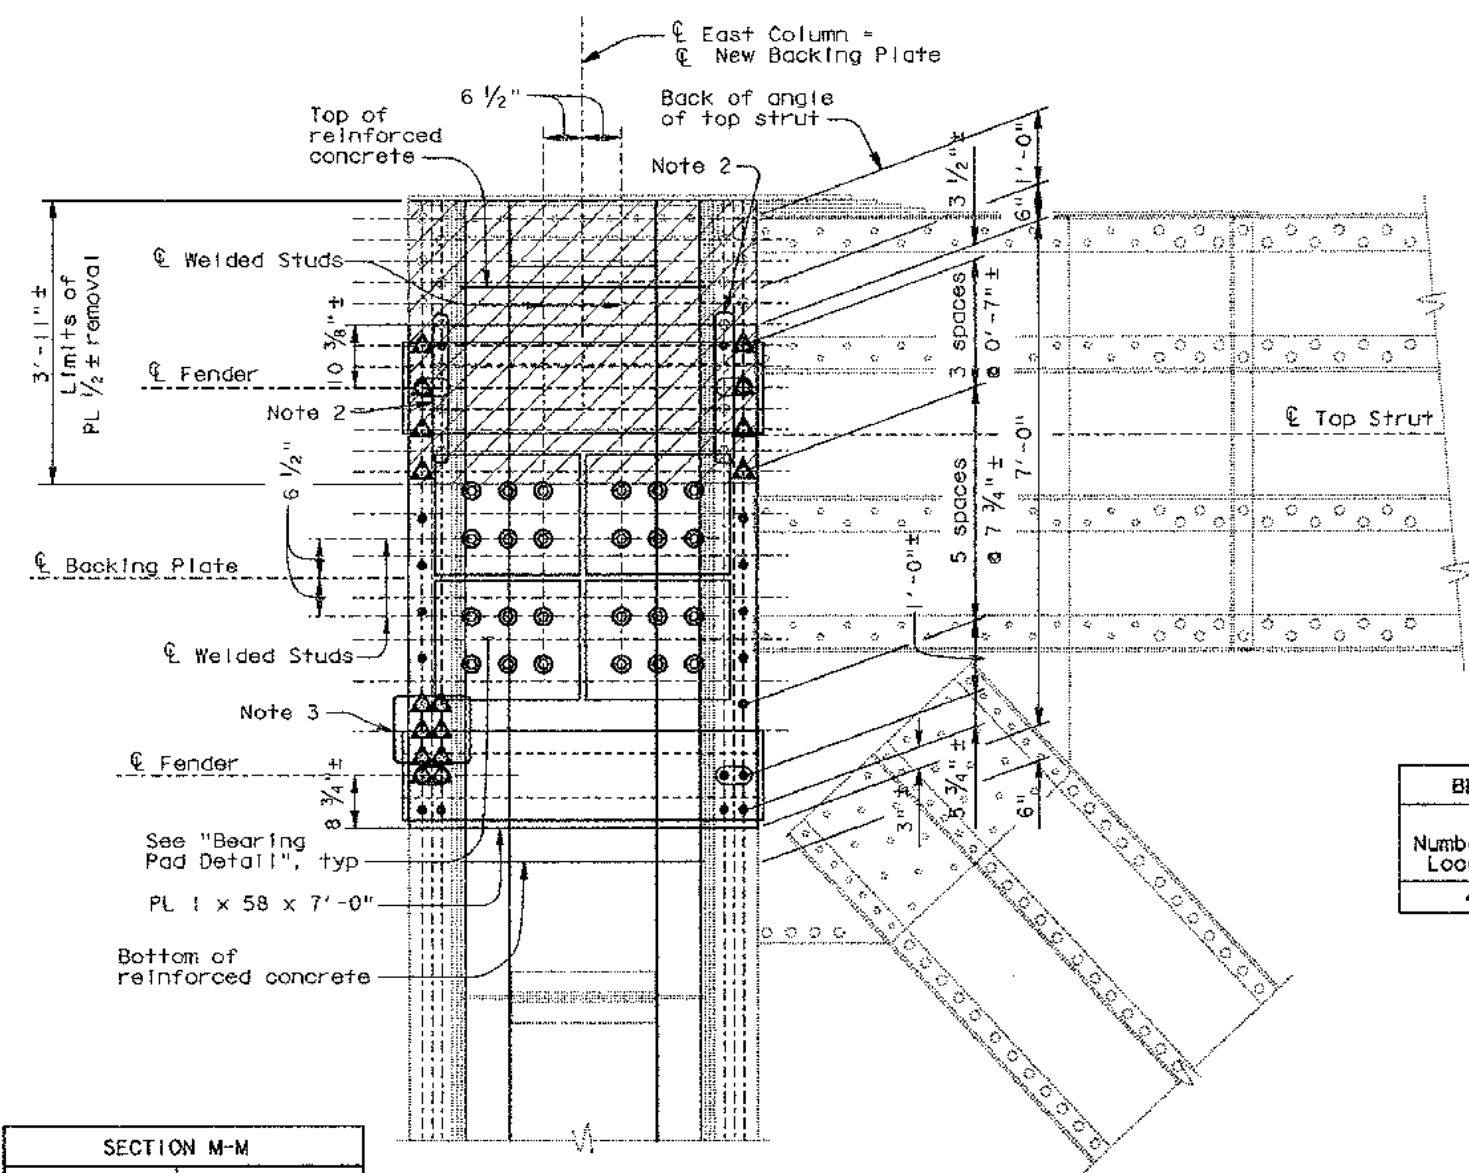


SECTION M-M	
Number Per Location	Approximate Grip Length (Inches)
42	1 3/4
12	2 1/4

SECTION M-M
3/4" = 1'-0"


Northeast column shown, southeast column similar by opposite hand

BEARING PAD DETAIL	
Number Per Location	Approximate Grip Length (Inches)
48	2 1/2

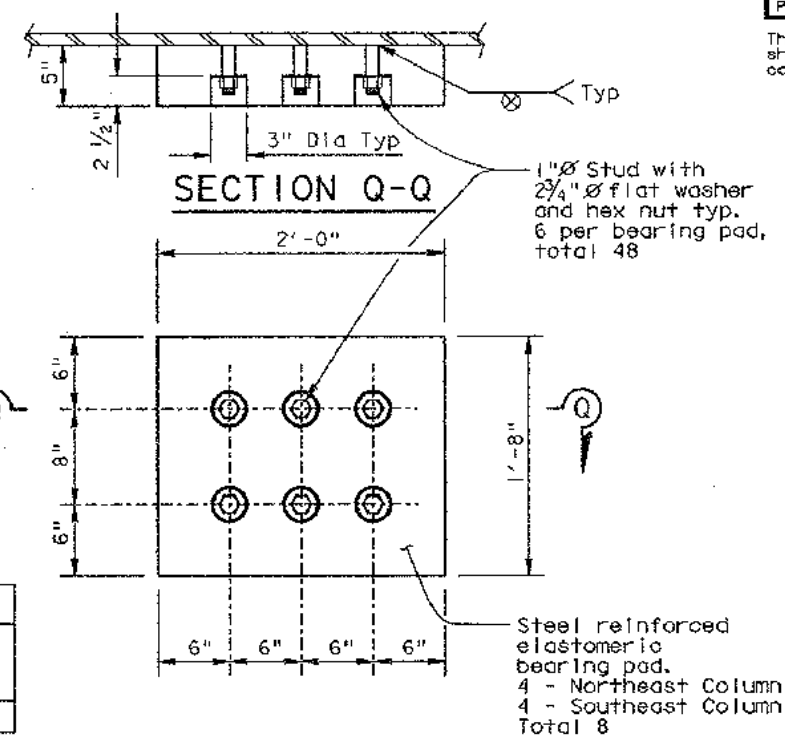

BEARING PAD DETAIL
1 1/2" = 1'-0"

SECTION N-N	
Number Per Location	Approximate Grip Length (Inches)
16	6 1/2

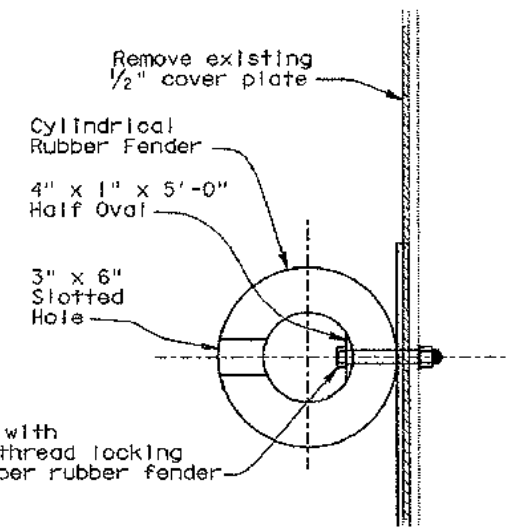

SECTION N-N
1 1/2" = 1'-0"

Notes:

- For location of Sections M-M and N-N see "Pier E4 Tower Bumper Details No. 1" sheet.
- Remaining existing rivets within the new backing plate location shall be removed.
- Rivets supporting the maintenance platform shall be replaced with HS bolts through the new backing plate.

LEGEND

- Indicates existing structures.
- Indicates existing rivets to be removed and replaced with new 1"Ø high strength bolts, unless otherwise noted.
- Indicates approx. location of existing rivets
- Indicates new 1"Ø high strength bolts.
- Indicates limits of removal of existing steel cover plate


NOTE:
THE CONTRACTOR SHALL VERIFY ALL CONTROLLING FIELD DIMENSIONS BEFORE ORDERING OR FABRICATING ANY MATERIAL.

INTERIM SEISMIC RETROFIT PROJECT
 EAST BAY CANTILEVER TRUSS
 SAN FRANCISCO-OAKLAND BAY BRIDGE
 PIER E4 BUMPER DETAILS NO. 2

DESIGN	BY J. LYNCH	3-97	CHECKED J. GUNDBROM	5-97	STATE OF CALIFORNIA	DIVISION OF STRUCTURES	BRIDGE NO.
DETAILS	BY D.A. SANDERSON	3-97	CHECKED J. GUNDBROM	5-97	DEPARTMENT OF TRANSPORTATION	STRUCTURE DESIGN	33-0025
QUANTITIES	BY J. LYNCH	5-97	CHECKED J. SIBBERS	5-97		TOLL BRIDGE SPECIAL ANALYSIS	POST MILE
							1.15
ORIGINAL SCALE IN INCHES FOR REDUCED PLANS						CU 04	DISREGARD PRINTS BEARING EARLIER REVISION DATES
						EA 043001	17 18

DATE PLOTTED: 9-06-1997
 TIME PLOTTED: 08:07

The State of California or its officers or agents shall not be responsible for the accuracy or completeness of electronic copies of this plan sheet.

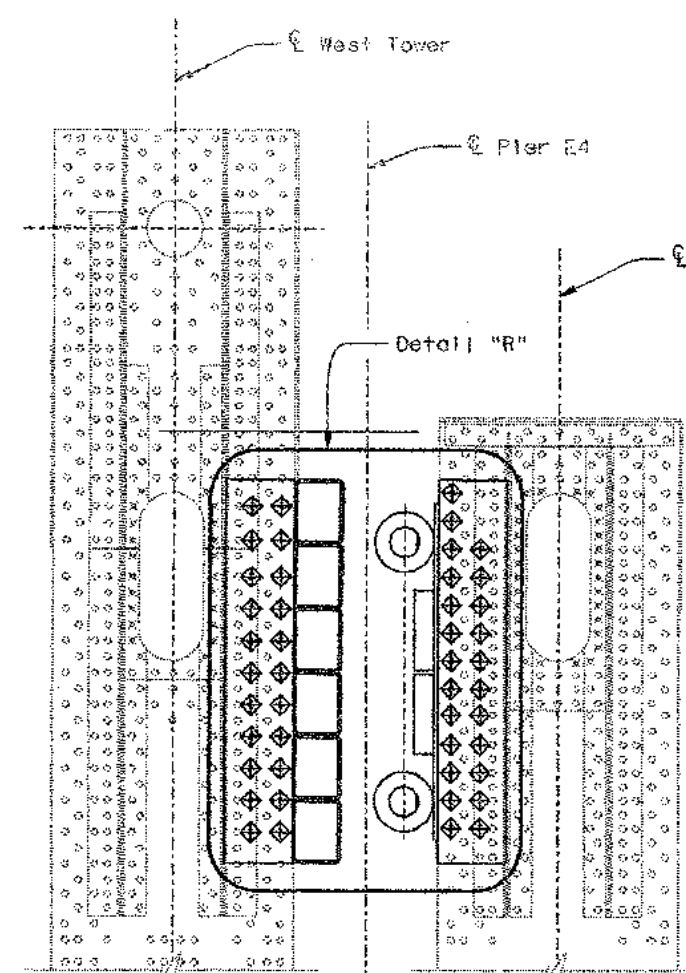

SECTION O-O
1/2" = 1'-0"


- Notes:
- For location of Sections O-O and P-P see "Pier E4 Tower Bumper Details No. 1" sheet.
 - Remaining existing rivets within the new structural tube assembly locations shall be removed.

LEGEND

- Indicates existing structures.
- Indicates location of existing rivets to be removed. Existing rivet hole to be reused for placement of structural tube assembly.
- Indicates new 1" HS Rod
- Indicates approx. location of existing rivets
- Indicates location of new 1 1/4" cored hole for 1" stud, unless otherwise noted.
- Indicates limits of removal of existing steel cover plate



SECTION P-P

Number Per Location	Approximate Strip Length (Inches)
132	3/4
12	1 1/4

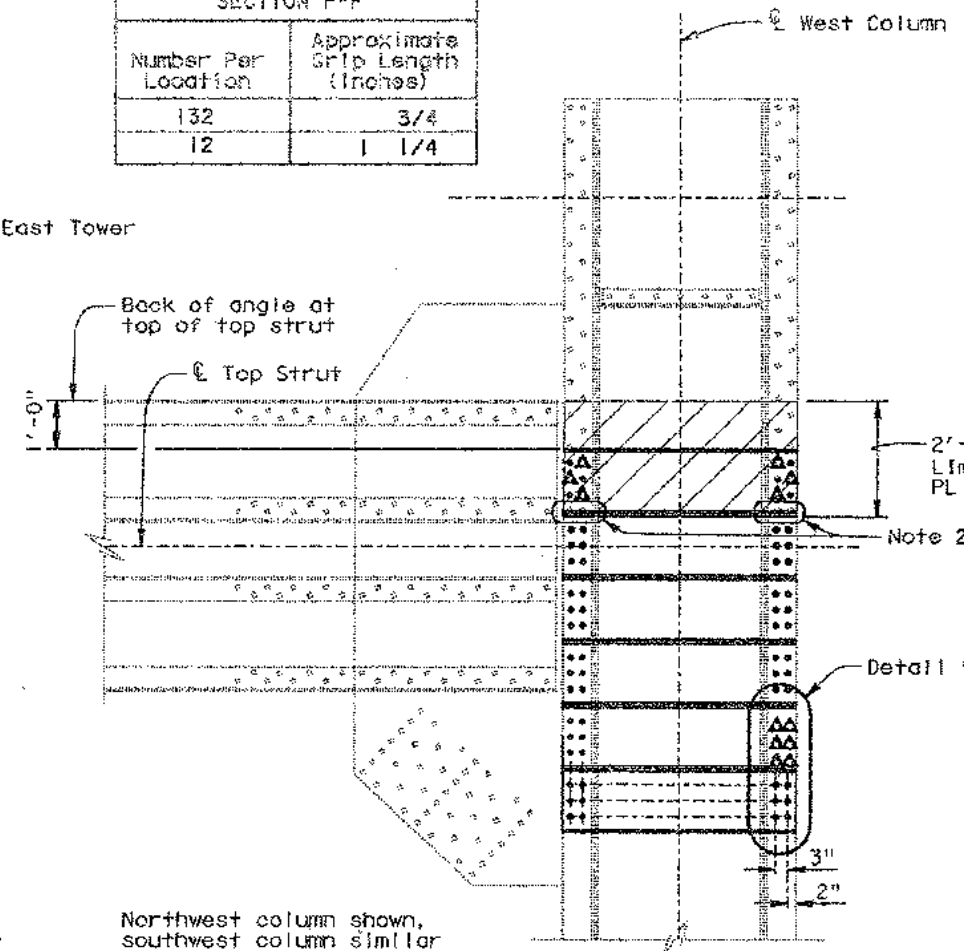

SECTION P-P
1/2" = 1'-0"

- Contractor shall provide full bearing between new concrete and new structural steel.
- Rivets supporting the maintenance platform shall be replaced with 1" welded studs through existing holes.

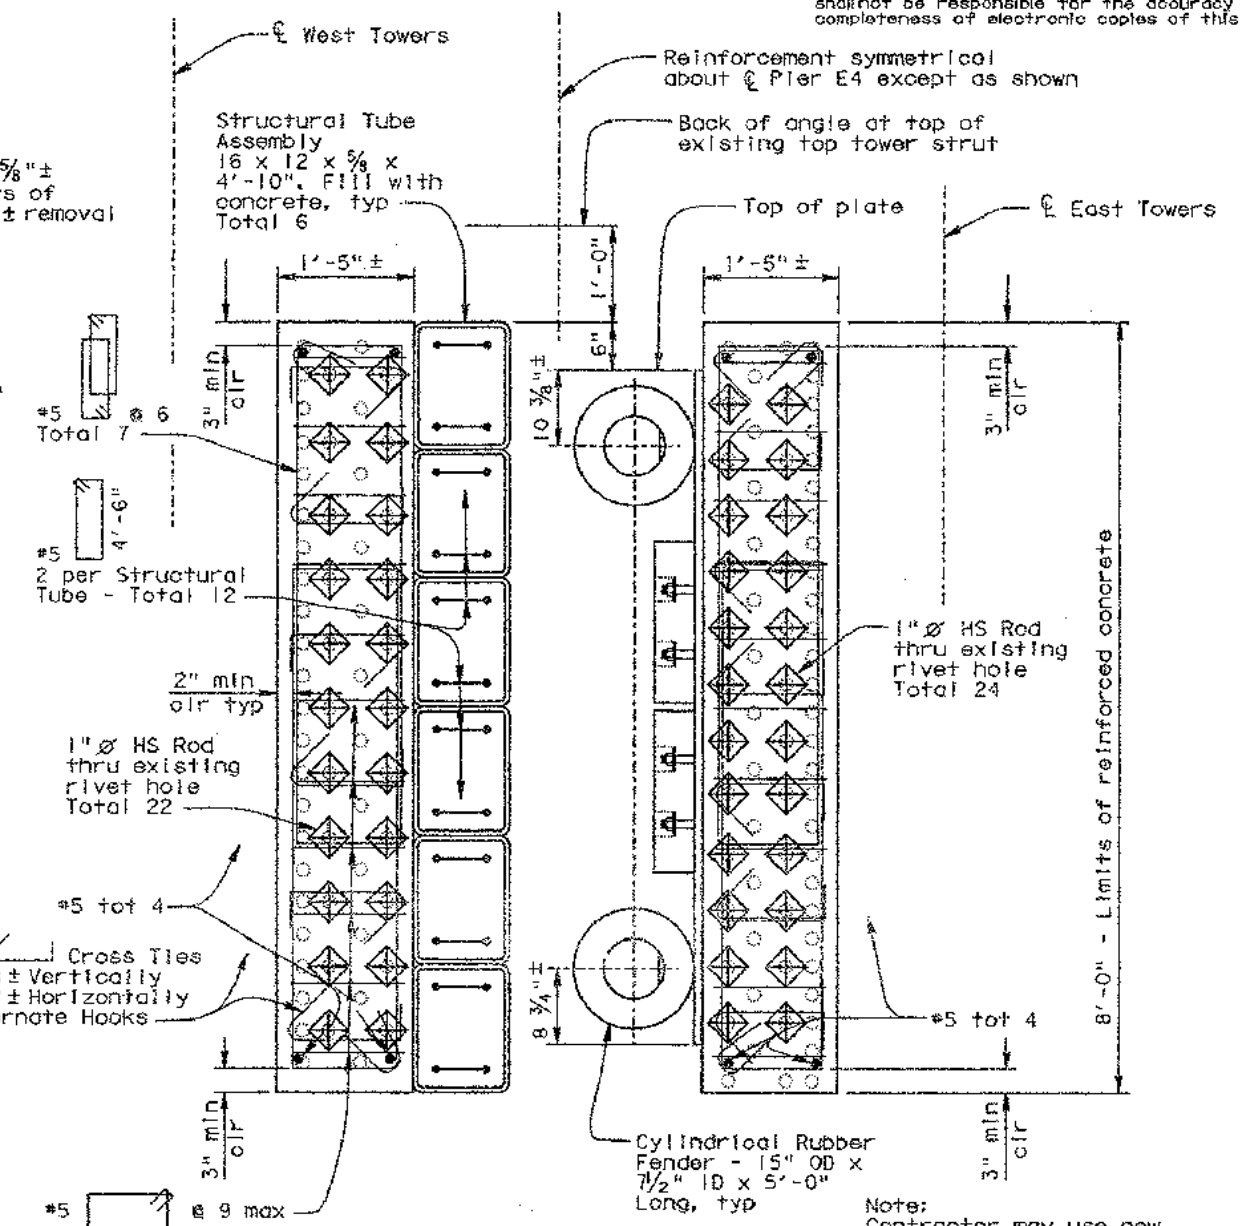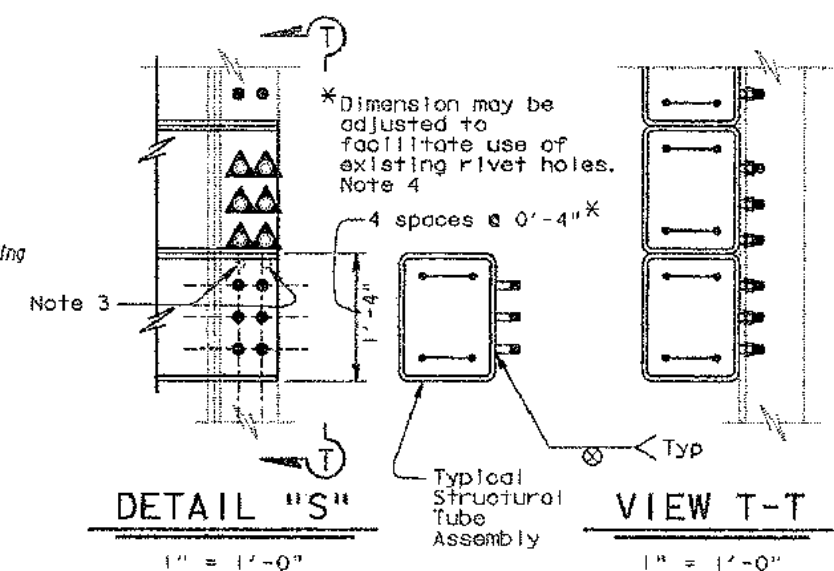

DETAIL "R"
1" = 1'-0"

NOTE:
THE CONTRACTOR SHALL VERIFY ALL CONTROLLING FIELD DIMENSIONS BEFORE ORDERING OR FABRICATING ANY MATERIAL.

Note:
Contractor may use new steel as forms for concrete. Provide 2" cover over all reinforcement except as shown.
North Tower Bumper shown, South Tower Bumper similar.

